
Greenwood

Form 51—5M—4-27—27423

Map No. KANSAS Sec. 29 Twp. 22 R. 13

Well No. 4 - Smith (Exthi) Farm

Amurada Pet Corp Company

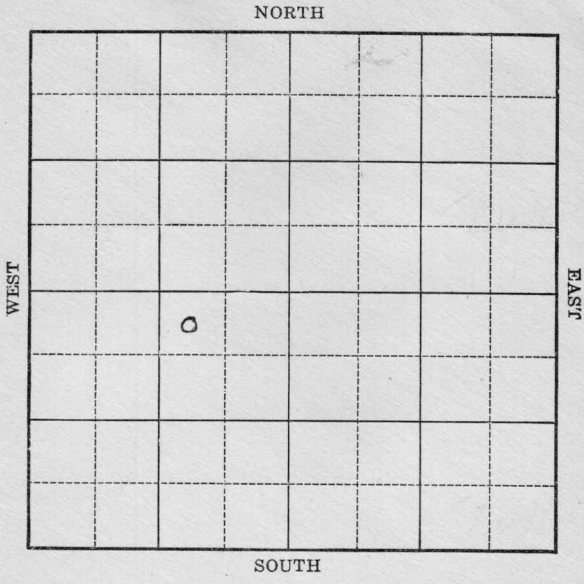


| | |
|---|---|
| Location | Rig Up |
| Drilling Remarks | Drilling Remarks |
| | |

| RECORD | | PRODUCTION | |
|---|---|---|---|
| Cased | in. ft. | 1st 24 hrs. Nat. | |
| Sand | | 1st 24 hrs. after shot | |
| Gas | | Gas | cu. ft. |
| Oil | | Dry Hole | |
| Total Depth | | Abandoned | |

Greenwood

Form 252A—5M—5-28—Mid-West

Map No. KANSAS Sec. 29 Twp. 22 R. 13

Well No. 4 - Lutkie Farm


Amerada Pet Company

330 Ft. from N. Line

Ft. from S. Line

990 Ft. from E. Line

Ft. from W. Line

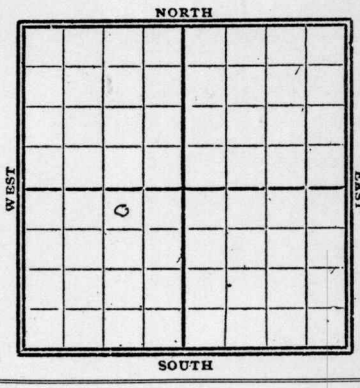


1928

| Date | REPORT |
|---|---|
| 10/17 | Rig up. |
| 10/24 | Spdg. |
| 10/31 | Drlg 1055' |
| 11/7 | sand 1669-1701' |
| | TD 1704' |
| | shot 120 qts - Glycerine |
| 11/14 | sand 1669-1701 |
| | TD 1704 |
| | shot 120 qts |
| | 50 bbls oil |
| | Swab |

FORM 26 250 BKS. 4-28 WESTERN

S Mwood

no record KANSAS

MAP NO. ____ SEC. 29 TWP. 22 R. 13

WELL NO. 4 Huth

Amerada Pet Co

COMPANY

CONTRACTOR

## FIRST REPORTS


330 FT. FROM N. LINE

____ FT. FROM S. LINE

990 FT. FROM E. LINE

____ FT. FROM W. LINE

## SECTION PLAT

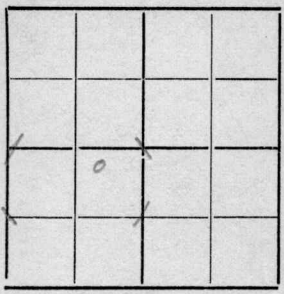

LOCATION ____

RIG UP ✓

DRILLING AND REMARKS:

## RECORD

CASED ____ IN., ____ FT.

SAND ____

GAS ____

OIL ____

TOTAL DEPTH ____

## PRODUCTION

1ST 24 HRS. NAT. ____

1ST 24 HRS. AFTER SHOT ____

GAS ____ CU. FT.

DRY HOLE ____

ABANDONED ____

DATE

OCT 17 1928 192____

CHAS. L. SHERWOOD

SCOUT

FORM 26 250 BKS. 4-28 WESTERN

Sherwood

No Kansas

MAP NO. _____ SEC. 29 TWP. 22 R. 13

WELL NO. 4 Ruth


Amerada Pet Co.

COMPANY

CONTRACTOR

COMPLETED

SECTION PLAT

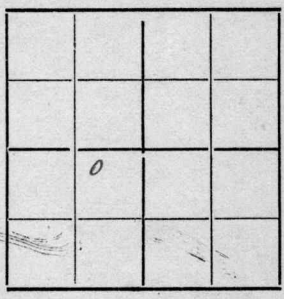

330 FT. FROM N. LINE

FT. FROM S. LINE

990 FT. FROM E. LINE

FT. FROM W. LINE

LOCATION

RIG UP

DRILLING AND REMARKS:

120/50 Bbs.

RECORD

CASED _____ IN., _____ FT.

SAND 1669-1701

GAS _____

OIL _____

TOTAL DEPTH 1704

PRODUCTION

1ST 24 HRS. NAT. _____

1ST 24 HRS. AFTER SHOT _____

GAS _____ CU. FT.

DRY HOLE _____

ABANDONED _____

DATE

NOV 14 1928

CHAS. L. SHERWOOD

_____ 192__ _____ SCOUT