Greenwood


Form 51—5M—9-28—27423

Map No. KANSAS Sec. 29 Twp. 22 R. 13

Well No. 4 - Luthi Farm

Simmons & Rhodes Company

NORTH

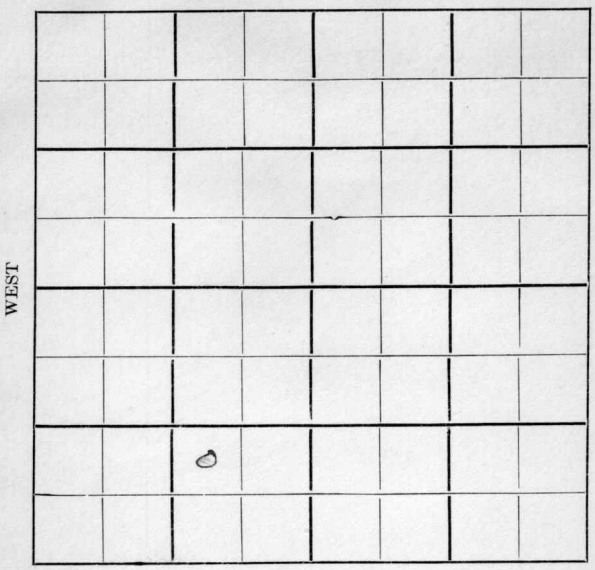

SOUTH

Location

Drilling Remarks

Rig Up

Drilling Remarks

RECORD

Cased ..... in. ..... ft.

Sand .....

Gas .....

Oil .....

Total Depth .....

PRODUCTION

1st 24 hrs. Nat. .....

1st 24 hrs. after shot .....

Gas. ..... cu. ft.

Dry Hole .....

Abandoned .....


Greenwood

FORM 252A-5M-12-28-PETROL

Map No. KANSAS Sec. 29 Twp. 22 R. 13

Well No. 4 - Lucki Farm

Simmons & Rhodes Company

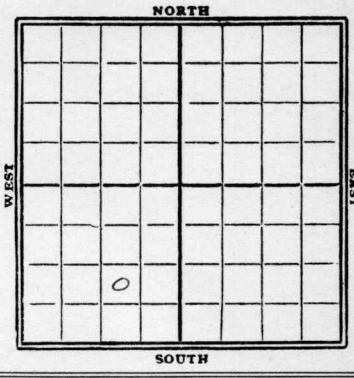

_____ Ft. from N. Line

990 Ft. from S. Line

990 Ft. from E. Line

_____ Ft. from W. Line

1929

Date	REPORT
1/30	Location
2/6	
2/13	
2/20	Rigging up
2/27	Spudg.
3/5	" 200'
3/13	Drlg 850'
3/20	" 1400'
3/27	sand 1686-96'
	T.D. 1696'
	shot 40 qts
	30 bbls oil
	Comp.

Form 26—1M Bks.—9-26

Greenwood

Norman KANSAS

Map No. ..... Sec. 29 Twp. 22 R. 13

Well No. 4 Luthi

Simmons & Rhodes Company

..... Contractor

FIRST REPORTS


..... Ft. from N. Line

990 Ft. from S. Line

990 Ft. from E. Line

..... Ft. from W. Line

SECTION PLAT

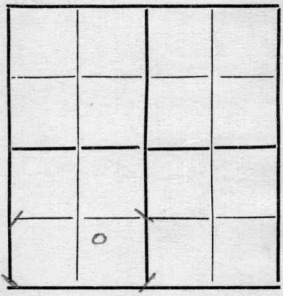

Location ✓

Rig up .....

Drilling and Remarks:

RECORD

Cased ..... in., ... ft.

Sand .....

Gas .....

Oil .....

Total Depth .....

PRODUCTION

1st 24 hrs. Nat. .....

1st 24 hrs. after shot .....

Gas ..... Cu. Ft.

Dry Hole .....

Abandoned .....

Date

JAN 30 1929

..... 192.....

CHAS. L. SHERWOOD

..... Scout

Form 26—1M Bks.—9-28

Sherwood

KANSAS

Map No. no map Sec. 29 Twp. 22 R. 13

Well No. 4 Ruth

Simmons & Rhodes Company

Contractor

COMPLETE


SECTION PLAT

..... Ft. from N. Line

990 Ft. from S. Line

990 Ft. from E. Line

..... Ft. from W. Line

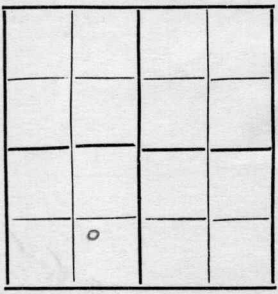

Location.....

Rig up.....

Drilling and Remarks:

40/30 Lbs.

RECORD

Cased ..... in., ... ft.

Sand 1686-1696

Gas.....

Oil.....

Total Depth 1696

PRODUCTION

1st 24 hrs. Nat.....

1st 24 hrs. after shot.....

Gas..... Cu. Ft.

Dry Hole.....

Abandoned.....

Date MAR 27 1929

CHAS. L. SHERWOOD

..... 192..... Scout