Grunwood


Form 51—5M—9-28—27423

Map No. KANSAS Sec. 29 Twp. 22 R. 13

Well No. 6 - Luthi Farm

Amurada Pet Company

NORTH

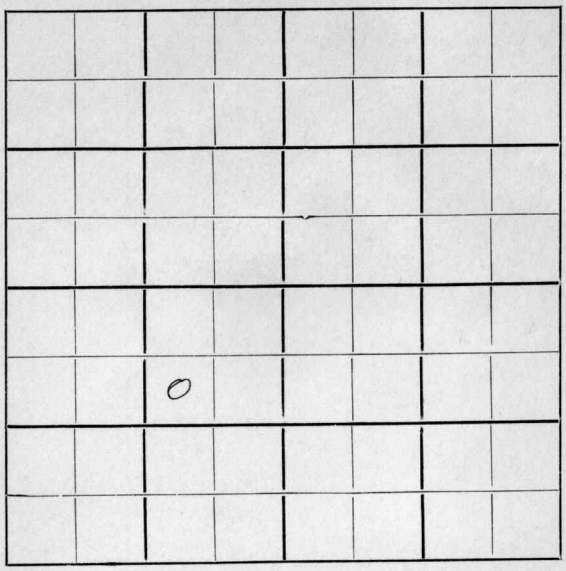

WEST

EAST

SOUTH

Location

Drilling Remarks

Rig Up

Drilling Remarks

RECORD

Cased ..... in. ..... ft.

Sand .....

Gas .....

Oil .....

Total Depth .....

PRODUCTION

1st 24 hrs. Nat. .....

1st 24 hrs. after shot .....

Gas ..... cu. ft. .....

Dry Hole .....

Abandoned .....

Greenwood

FORM 252A-5M-12-28-PETROL

Map No. KANSAS Sec. 29 Twp. 22 R. 13

Well No. 6 - Lucki Farm


Amerada Pet Company

990 Ft. from N. Line

_____ Ft. from S. Line

990 Ft. from E. Line

_____ Ft. from W. Line

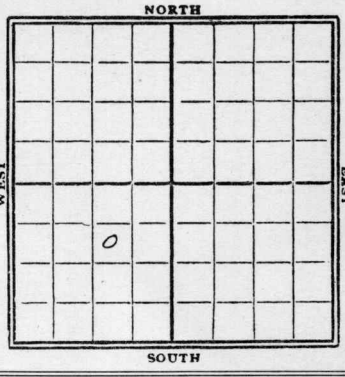

1929

Date	REPORT
1/23	Co G
1/30	Rig
2/6	"
2/13	Spdy 230'
2/20	20 Rig 800'
2/27	" 1215'
3/6	sand 1666-92'
	shot 100 qts - Glycout
3/13	sand 1666-92'
	T.D. 1692'
	shot 100 qts
	75 Bbls oil
	Comp.

Form 26—1M Bks.—9-26

Greenwood

Womp KANSAS

Map No. ..... Sec. 29 Twp. 22 R. 13

Well No. 6 Ruthi

Amerada Petr Co ..... Company

..... Contractor

FIRST REPORTS


990 Ft. from N. Line

..... Ft. from S. Line

990 Ft. from E. Line

..... Ft. from W. Line

SECTION PLAT

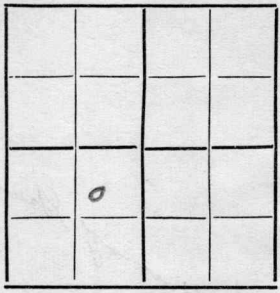

Location .....

Rig up R.O.G.

Drilling and Remarks:

RECORD

Cased ..... in., ... ft.

Sand .....

Gas .....

Oil .....

Total Depth .....

PRODUCTION

1st 24 hrs. Nat. .....

1st 24 hrs. after shot .....

Gas ..... Cu. Ft.

Dry Hole .....

Abandoned .....

Date

JAN 23 1929

..... 192.....

CHAS. L. SHERWOOD

..... Scout

Form 26—1M Bks.—9-28

B Sherwood

Map No. KANSAS Sec. 29 Twp. 22 R. 13

nonop Kuthi

Well No. 6

Amerada Petr Corp Company

Contractor

COMPLETE


990 Ft. from N. Line

Ft. from S. Line

990 Ft. from E. Line

Ft. from W. Line

SECTION PLAT

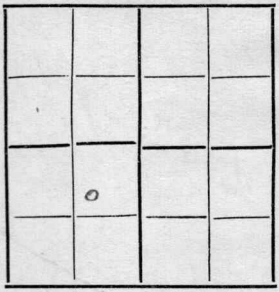

Location

Rig up

Drilling and Remarks:

100/75 Bbls.

RECORD

Cased in., ft.

Sand 1666 - 1692

Gas

Oil

Total Depth 1692

PRODUCTION

1st 24 hrs. Nat.

1st 24 hrs. after shot

Gas Cu. Ft.

Dry Hole

Abandoned

Date

MAR 13 1929

192

CHAS. L. SHERWOOD

Scout