


Map No. _____ Sec. 1 Twp. 26 R. 4

Well No. 38 Porter Farm _____

Porter Company _____

NORTH

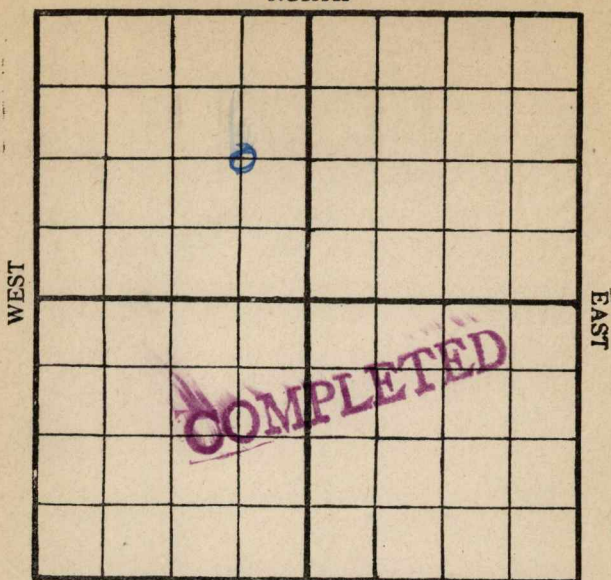

SOUTH

Location _____

Rig Up _____

Drilling Remarks:

Drilling Remarks:

RECORD

Cased _____ in. _____ ft.

Sand _____

Gas _____

Oil _____

Total Depth _____

PRODUCTION

1st 24 hrs. Nat. _____

1st 24 hrs. after shot _____

Gas _____ cu. ft.

Dry Hole _____

Abandoned _____


Map No. H14 Sec. 1 Twp. 26 R. 4

Well No. 38 Porter Farm

Porter Company

NORTH

WEST

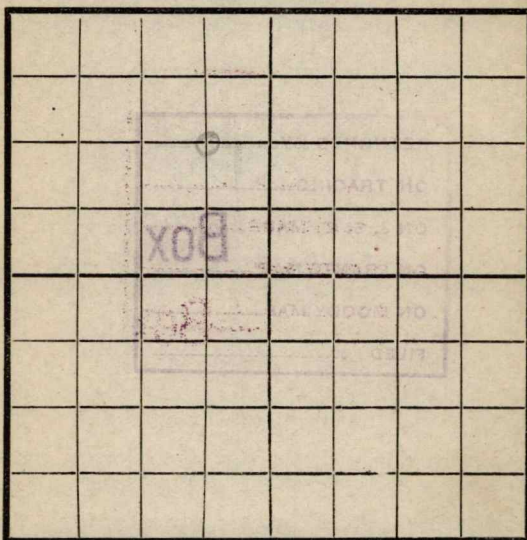

EAST

SOUTH

Location ✓

Rig Up ✓

Drilling and remarks

RECORD

Cased _____ in. _____ Ft.

Sand _____

Gas _____

Oil _____

Total Depth _____

PRODUCTION

1st 24 hrs. Nat. _____

1st 24 hrs. after shot _____

Gas _____ Cu. Ft.

Dry Hole _____

Abandoned _____

FIRST REPORT


Date

3/27, 1911 S. C. Cady Scout

Map No. _____ Sec. 1 Twp. 26 R. 4
Well No. 38 Porter Farm
Cartee Company

NORTH

WEST

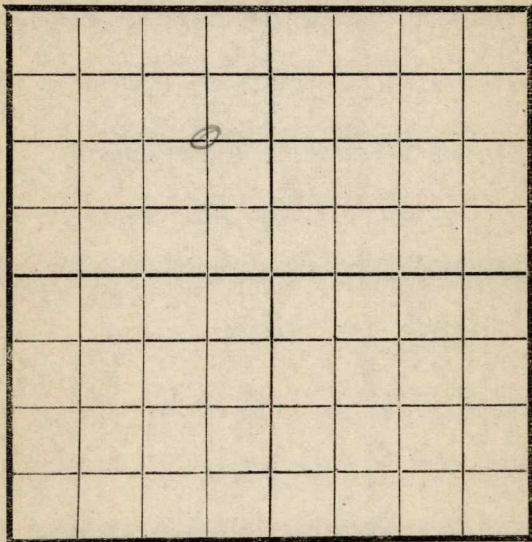

EAST

SOUTH

Location _____

Rig Up _____

Drilling and remarks

*Rigging up
Cartee Co
Tools*

RECORD

Cased _____ in _____ Ft

Sand _____

Gas _____

Oil _____

Total Depth _____

PRODUCTION

1st 24 hrs. Nat. _____

1st 24 hrs. after shot _____

Gas _____ Cu. Ft.

Dry Hole _____

Abandoned _____


Date

5/8, 1911 J. C. Canady Scout

Map No. _____ Sec. 1 Twp. 26 R. 4Well No. 38 Porter Farm _____
Porter Company _____

NORTH

WEST

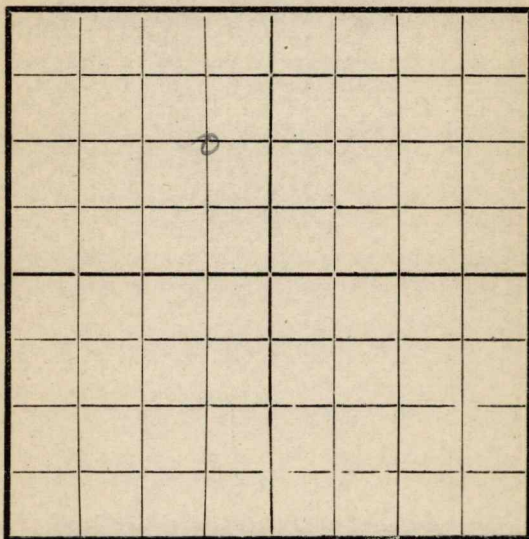

EAST

SOUTH

Location _____

Rig Up _____

Drilling and remarks

185

RECORD

Cased _____ in. _____ Ft.

Sand _____

Gas _____

Oil _____

Total Depth _____

PRODUCTION

1st 24 hrs. Nat. _____

1st 24 hrs. after shot _____

Gas _____ Cu. Ft.

Dry Hole _____

Abandoned _____


Date

5/15, 1918 Scout Scout

Map No. _____ Sec. 1 Twp. 26 R. 4
 Well No. 38 Pnter Farm _____
Carter Company _____

NORTH

WEST

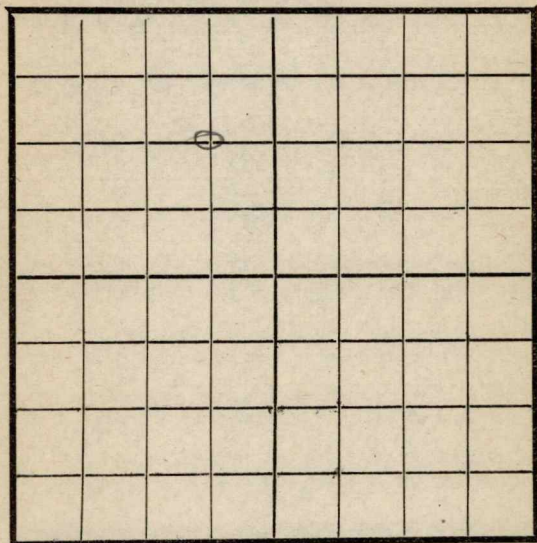

EAST

SOUTH

Location _____

Rig Up _____

Drilling and remarks

620

RECORD

Cased _____ in. _____ Ft.

Sand _____

Gas _____

Oil _____

Total Depth _____

PRODUCTION

1st 24 hrs. Nat. _____

1st 24 hrs. after shot _____

Gas _____ Cu. Ft.

Dry Hole _____

Abandoned _____

Date

5/22 1911

P. Candy


Scout

Map No.----- Sec. 1 Twp. 26 R. 4

Well No. 38 Porter Farm
Carter Company

NORTH

WEST

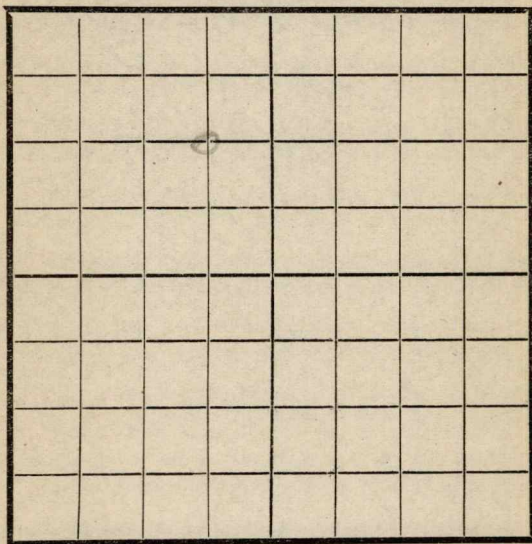

EAST

SOUTH

Location -----

Rig Up -----

Drilling and remarks

980

RECORD

Cased ----- in. ----- Ft.

Sand -----

Gas -----

Oil -----

Total Depth -----

PRODUCTION

1st 24 hrs. Nat. -----

1st 24 hrs. after shot -----

Gas ----- Cu. Ft.

Dry Hole -----


Abandoned -----

Date

5/29, 1911 P. C. Candy Scout

Map No. _____ Sec. 1 Twp. 26 R. 4Well No. 38 Porter_____
Company_____
Contractor

NORTH

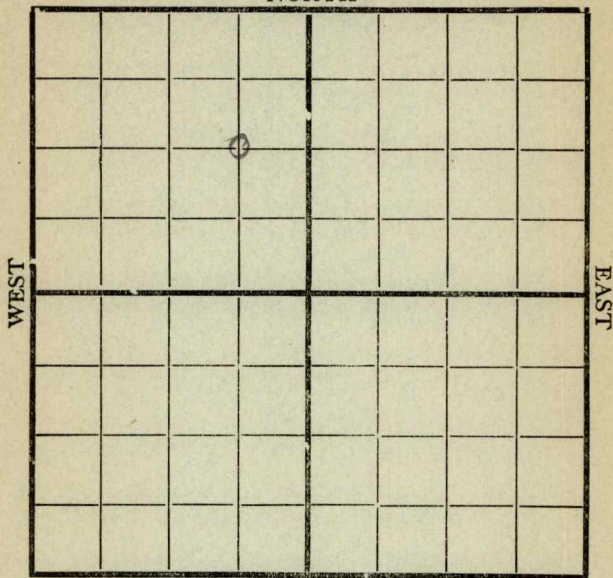

SOUTH

Location _____

Rig up _____

Drilling and Remarks:

1315

RECORD

Cased _____ in., _____ ft.

Sand _____

Gas _____

Oil _____

Total Depth _____

PRODUCTION

1st 24 hrs. Nat. _____

1st 24 hrs. after shot _____

Gas _____ Cu. Ft.

Dry Hole _____

Abandoned _____

Date

6/5

191

8. Cassidy

Scout

Map No. _____ Sec. 1 Twp. 26 R. 4Well No. 38 PorterCenter

Company _____

Contractor _____

NORTH

WEST

EAST

SOUTH

Location _____

Rig up _____

Drilling and Remarks:

1618

RECORD

Cased _____ in., _____ ft.

Sand _____

Gas _____

Oil _____

Total Depth _____

PRODUCTION

1st 24 hrs. Nat. _____

1st 24 hrs. after shot _____

Gas _____ Cu. Ft.

Dry Hole _____

Abandoned _____


Date

6/121918S. C. Cuddy

Scout

Map No. _____ Sec. 1 Twp. 26 R. 4
Well No. 38 Porter Farm _____
Center Company _____

NORTH

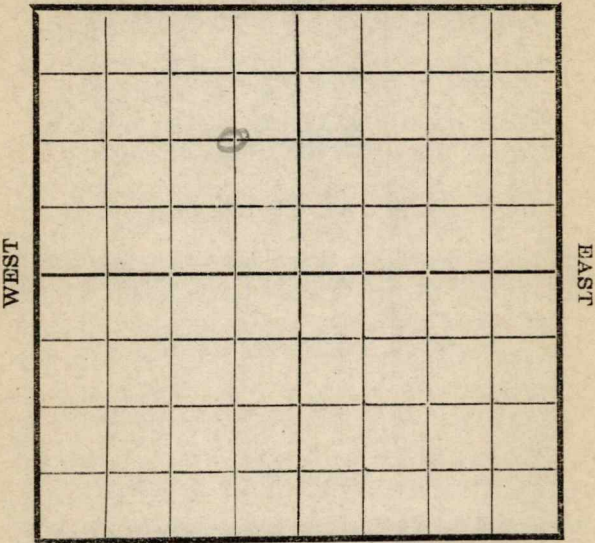


SOUTH

	RECORD
Location _____	Cased _____ in. _____ Ft
Rig Up _____	Sand _____
Drilling and remarks	Gas _____
<u>1935</u>	Oil _____
	Total Depth _____
	PRODUCTION
	1st 24 hrs. Nat. _____
	1st 24 hrs. after shot _____
	Gas _____ Cu. Ft.
	Dry Hole _____
	Abandoned _____

Date 6/19, 1918 J. C. C. C. Scout

Map No. _____ Sec. 1 Twp. 26 R. 4
Well No. 38 Porter
Center _____ Company _____
Contractor _____

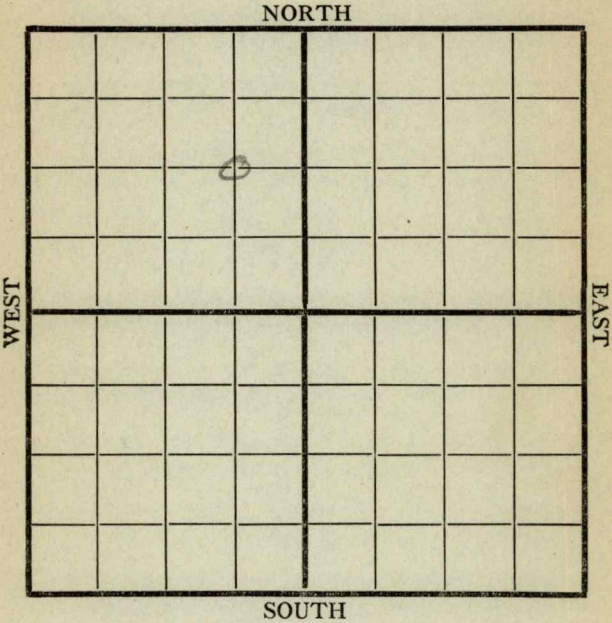

	RECORD
Location _____	Cased _____ in., _____ ft.
Rig up _____	Sand _____
Drilling and Remarks: <u>2075</u>	Gas _____
	Oil _____
	Total Depth _____
	PRODUCTION
	1st 24 hrs. Nat. _____
	1st 24 hrs. after shot _____
	Gas _____ Cu. Ft.
	Dry Hole _____
	Abandoned _____

Date 6/26 1918 Conley Scout

Map No. _____ Sec. 1 Twp. 26 R. 4Well No. 38 Porter

_____ Company

_____ Contractor

NORTH

WEST

EAST

SOUTH

Location _____

Rig up _____

Drilling and Remarks:

2225

RECORD

Cased _____ in., _____ ft.

Sand _____

Gas _____

Oil _____

Total Depth _____

PRODUCTION

1st 24 hrs. Nat. _____

1st 24 hrs. after shot _____

Gas _____ Cu. Ft.

Dry Hole _____

Abandoned _____

Date

7/3

191

J. C. Conley

Scout

Map No. _____ Sec. 1 Twp. 26 R. 4

Well No. 38 Porter

_____ **Company**

Contractor

NORTH

WEST

EAST

SOUTH

Location _____

Rig up_____

Drilling and Remarks:

Shut Down
2225

RECORD

Cased_____in., _____ft.

Sand_____

Gas -----

Oil _____

Total Depth.....

PRODUCTION

1st 24 hrs. Nat. _____

1st 24 hrs. after shot.....

Gas.....Cu. Ft.

Dry Hole

Abandoned.....

Date _____

7/10 191 S. C. Scout

Scout

Map No. _____ Sec. 1 Twp. 26 R. 4Well No. 38 Porter

_____ Company

_____ Contractor

NORTH

WEST

EAST

SOUTH

Location _____

Rig up _____

Drilling and Remarks:

mp sand
2399

RECORD

Cased _____ in., _____ ft.

Sand _____

Gas _____

Oil _____

Total Depth _____

PRODUCTION

1st 24 hrs. Nat. _____

1st 24 hrs. after shot _____

Gas _____ Cu. Ft.

Dry Hole _____

Abandoned _____

Date

7/17 191 J. C. Caudy Scout

Map No. K14 Sec. 1 Twp. 26 R. 4Well No. 38 PorterCompany PorterContractor Company

NORTH

WEST

EAST

SOUTH

Location _____

Rig up _____

Drilling and Remarks:

Est at
200
Blues

RECORD

Cased _____ in. _____ ft.

Sand 2399-2424

Gas _____

Oil _____

Total Depth _____

PRODUCTION

1st 24 hrs. Nat. _____

1st 24 hrs. after shot _____

Gas _____ Cu. Ft.

Dry Hole _____

Abandoned _____

Date

7/25/1918 Porter Scout