
Greenwood

Form 51—5M—9-28—27423

Map No. KANSAS Sec. 29 Twp. 22 R. 13

Well No. 5 - Tuttle Farm

Amerada Pet Company

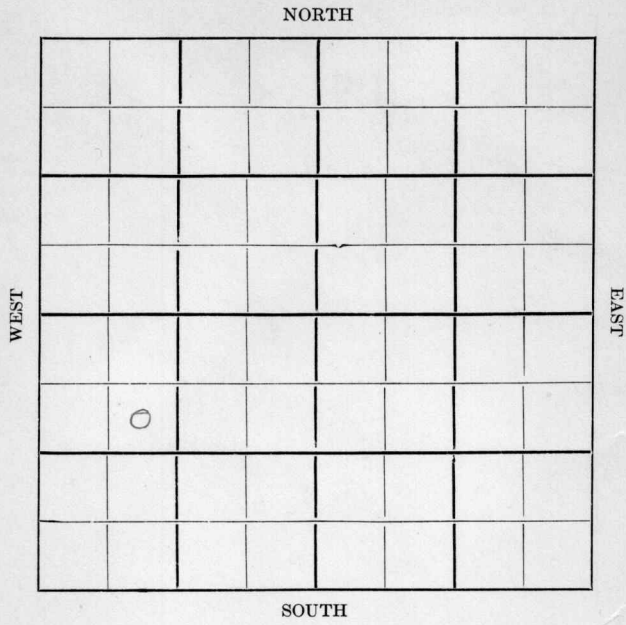

Location

Drilling Remarks

Rig Up

Drilling Remarks

RECORD

Cased ..... in. ..... ft.

Sand

Gas

Oil

Total Depth

PRODUCTION

1st 24 hrs. Nat.

1st 24 hrs. after shot

Gas. ..... cu. ft.

Dry Hole

Abandoned

Grunwood

Form 252A—5M—5-28—Mid-West

Map No. KANSAS Sec. 29 Twp. 22 R. 13

Well No. 5 - Smith Farm


Amurada Pet Company

990 Ft. from N. Line

Ft. from S. Line

Ft. from E. Line

990 Ft. from W. Line

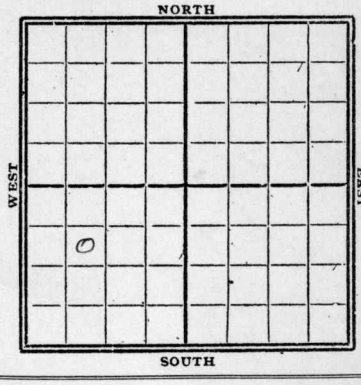

1928

Date	REPORT
11/21	Location
11/28	
12/5	Timbers
12/12	Rigging up
12/19	Drlg 415'
12/26	" 720'
1929	
1/2	Sand 1325'
1/9	sand 1689-1711'
	T.D. 1715 - 100' oil in hole
	Will shoot
1/16	sand 1689-1711'
	T.D. 1715'
	shot 80 qts
	125 bbls oil
	Pump

FORM 26 250 BKS. 4-28 WESTERN

No Casing

S Murrow

MAP NO. KANSAS SEC. 29 TWP. 22 R. 13

WELL NO. 5 Luthi

Amerada Pet Co COMPANY

CONTRACTOR

FIRST REPORTS


990 FT. FROM N. LINE

FT. FROM S. LINE

FT. FROM E. LINE

990 FT. FROM W. LINE

SECTION PLAT

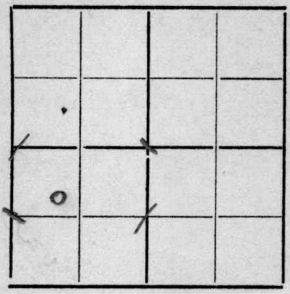

LOCATION ✓

RIG UP

DRILLING AND REMARKS:

RECORD

CASED IN., FT.

SAND

GAS

OIL

TOTAL DEPTH

PRODUCTION

1ST 24 HRS. NAT.

1ST 24 HRS. AFTER SHOT

GAS CU. FT.

DRY HOLE

ABANDONED

DATE

NOV 21 1928 CHAS. L. SHERWOOD

192 SCOUT

FORM 26 250 BKS. 4-28 WESTERN

C. L. Sherwood

Nomad

KANSAS

MAP NO. _____ SEC. 29 TWP. 22 R. 13

WELL NO. 5 Luthi

Amerada Pet COMPANY

_____ CONTRACTOR

COMPLETE


990 FT. FROM N. LINE

_____ FT. FROM S. LINE

_____ FT. FROM E. LINE

990 FT. FROM W. LINE

SECTION PLAT

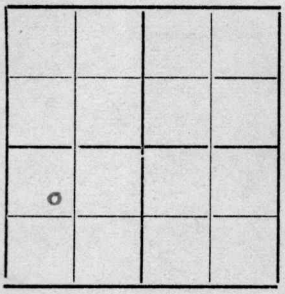

LOCATION _____

RIG UP _____

DRILLING AND REMARKS:

80/175 BS. 7"

RECORD

CASED 1689 IN., _____ FT.

SAND 1689-1711

GAS _____

OIL _____

TOTAL DEPTH 1715

PRODUCTION

1ST 24 HRS. NAT. _____

1ST 24 HRS. AFTER SHOT _____

GAS _____ CU. FT.

DRY HOLE _____

ABANDONED _____

DATE

JAN 16 1929

192____

CHAS. L. SHERWOOD

_____ SCOUT