


DX 78-1

Greenwood KANSAS

Section 29 Township 22 Range 13E

Well No. 8 Luthi-Unit

Company Geo. Sheehan

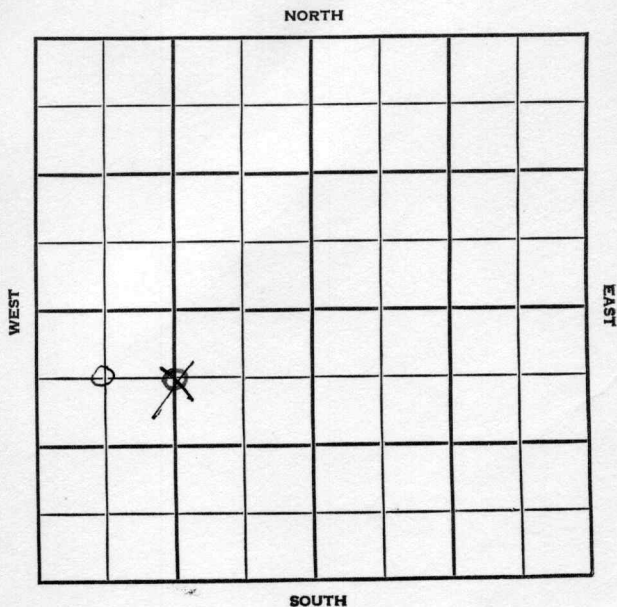

Greenwood

KANSAS

SEC.	TWP.	R.
29	22	13E

WELL NO.

#8 Luthi-Unit

FARM

COMPANY

Geo. Sheehan

CONTRACTOR

White & Ellis

Lamont Pool

660


Ft. from N. Line

Ft. from S. Line

Ft. from E. Line

Ft. from W. Line

NORTH

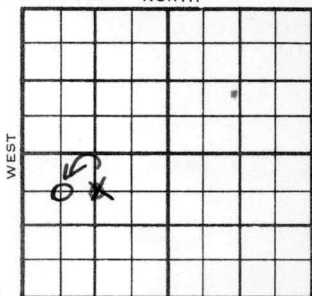

660
~~1320~~

CNW
~~C N $\frac{1}{2}$ SW~~

1954

ELEVATION

REPORT

12/29

Spud 12-26-54
 Drlg.

1955

2/16

Spud 12-26-54 - Water Input Well

TD 1702'

8" @ 80'

KC 1007', Bart. 1659'

TD 1678'

5" @ 1674'


DD 1702'

PB 1700' 20 qts. 1674-1700

Comp. water input well

ABANDONED

ABANDONED

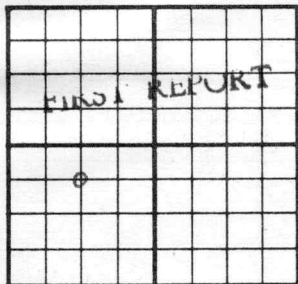County Greenwood State KansasSec. 29 (Blk.
Twp.) 22 (Sur.
Rge.) 13E Map No.Operator Geo. SheehanWell No. 8 Farm Luthi-UnitElev. Location C N $\frac{1}{2}$ SW660 Ft. From N Line SW1320 Ft. From W Line Quarter1st. Report DEC 29 1954

Completion

Remarks

White & Ellis - Contr.Spudding Date 12-26-54Drlg. Data Lamont Pooldrlg.

FABEN GILSTRAP

SCOUT TICKET

DX-201

Kansas

SEC.

29

TWP.

22S

R.

13E

WELL NO.

8 Luthi-Unit

FARM

COMPANY

Geo. Sheehan

CONTRACTOR

CORRECTION

C NW SW

660


FT. FROM N. LINE

FT. FROM S. LINE

FT. FORM E. LINE

660

FT. FROM W. LINE

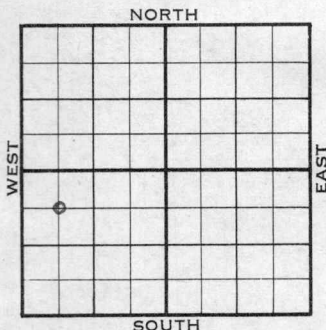

Greenwood County

☐

LOCATION

☐

RIG UP

DRILLING AND REMARKS:

Reported

C N $\frac{1}{2}$ SW

RECORD

CASED IN., FT.

SAND

GAS

OIL

TOTAL DEPTH

PRODUCTION

1ST 24 HRS. NAT.

1ST 24 HRS. AFTER SHOT

GAS CU. FT.

DRY HOLE


ABANDONED

DATE

JAN 5 1955

SCOUT

FABEN GILSTRAP

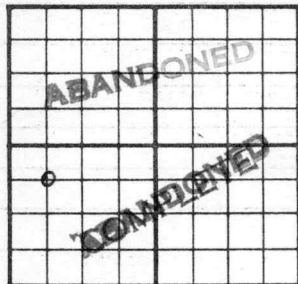County Greenwood State KansasSec. 29 (Blk.) 22 (Sur.) 13E Map No.Operator Geo. SheehanWell No. 8 Farm Luthi-UnitElev. Location C NW SW660 Ft. From N Line SW660 Ft. From W Line Quarter

1st. Report

Completion FEB 1 6 1955Remarks Lamont PoolWhite & Ellis - Contr.Spudding Date 12-26-54Drlg. Data Water input well TD 17028" @ 80 KC 1007 Bart. 1659TD 1678 5" @ 1674 DD 1702 PB 170020 qt/ 1674-1700 Comp. water input well

FABEN GILSTRAP