


Map No. 1714 Sec. 1 Twp. 26 R. 4Well No. 44 Porter Farm
Porter Company

NORTH

WEST

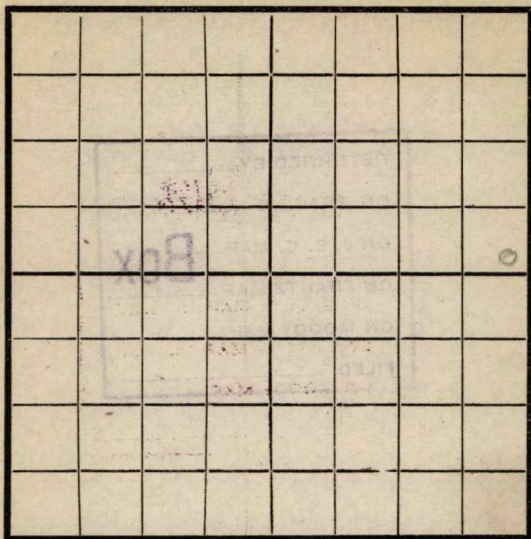

EAST

SOUTH

Location ✓Rig Up ✓

Drilling and remarks

RECORD

Cased _____ in. _____ Ft.

Sand _____

Gas _____

Oil _____

Total Depth _____

PRODUCTION

1st 24 hrs. Nat. _____

1st 24 hrs. after shot _____

Gas _____ Cu. Ft.

Dry Hole _____

Abandoned _____


FIRST REPORT

Date

3/27, 1918 Porter Scout

Map No. K14 Sec. 1 Twp. 26 R. 4Well No. 44 PorterPorter CompanyPorter Drilling Contractor

NORTH

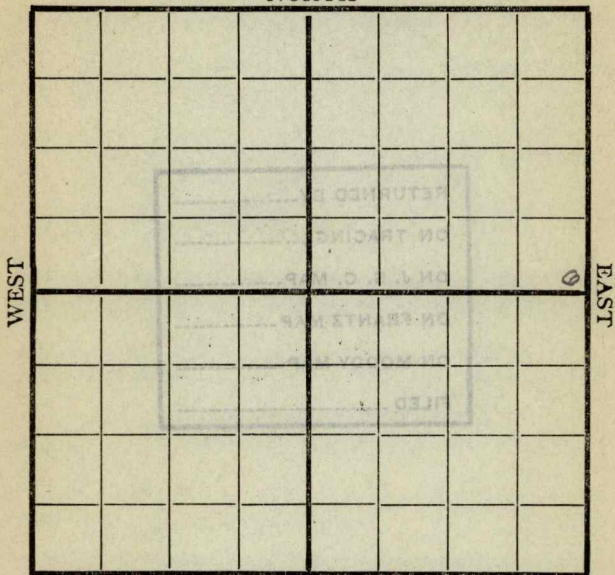

SOUTH

Location _____

Rig up _____

Drilling and Remarks:

Rigging up

RECORD

Cased _____ in., _____ ft.

Sand _____

Gas _____

Oil _____

Total Depth _____

PRODUCTION

1st 24 hrs. Nat. _____

1st 24 hrs. after shot _____

Gas _____ Cu. Ft.

Dry Hole _____


Abandoned _____

Date

6/12 1918 Porter Scout

Map No. _____ Sec. 1 Twp. 26 R. 4
 Well No. 44 Porter Farm _____
Porter Company _____

NORTH

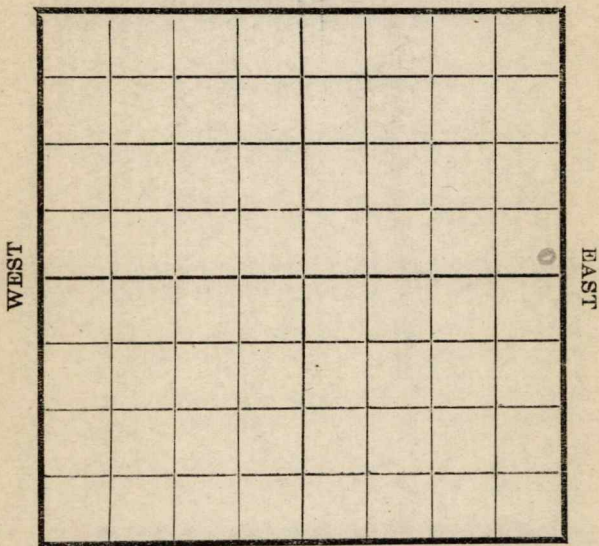

SOUTH

Location _____
 Rig Up _____
 Drilling and remarks

695

RECORD

Cased _____ in. _____ Ft.
 Sand _____
 Gas _____
 Oil _____
 Total Depth _____

PRODUCTION

1st 24 hrs. Nat. _____
 1st 24 hrs. after shot _____
 Gas _____ Cu. Ft.
 Dry Hole _____
 Abandoned _____

Date

6/19, 1918 C. Cardiff Scout


Map No. _____ Sec. 1 Twp. 26 R. 4Well No. 44 PorterCenter _____ Company

_____ Contractor

NORTH

WEST

EAST

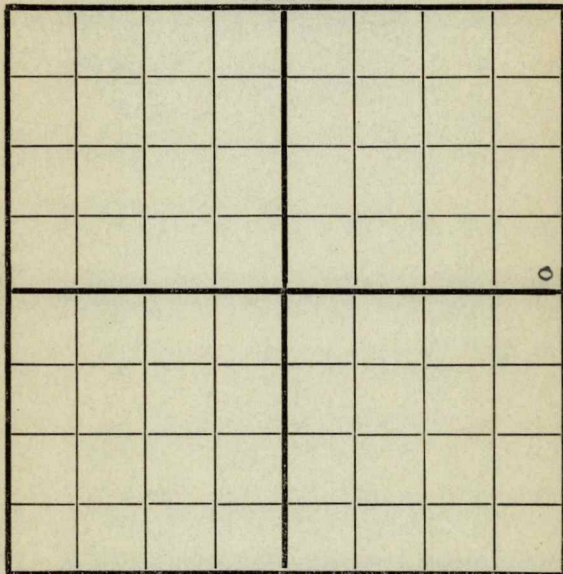

SOUTH

Location _____

Rig up _____

Drilling and Remarks:

870

RECORD

Cased _____ in., _____ ft.

Sand _____

Gas _____

Oil _____

Total Depth _____

PRODUCTION

1st 24 hrs. Nat. _____

1st 24 hrs. after shot _____

Gas _____ Cu. Ft.

Dry Hole _____

Abandoned _____

Date

6/26

191

C. C. C. Scout

Scout

Map No. _____ Sec. 6 Twp. 26 R. 4Well No. 44 Porter_____
Center Company_____
Contractor

NORTH

WEST

EAST

SOUTH

Location _____

Rig up _____

Drilling and Remarks:

980

RECORD

Cased _____ in., _____ ft.

Sand _____

Gas _____

Oil _____

Total Depth _____

PRODUCTION

1st 24 hrs. Nat. _____

1st 24 hrs. after shot _____

Gas _____ Cu. Ft.

Dry Hole _____

Abandoned _____

Date

7/3

191


J. C. Sandy Scout

Map No. _____ Sec. 1 Twp. 26 R. 4Well No. 44 Porter

_____ Company

_____ Contractor

NORTH

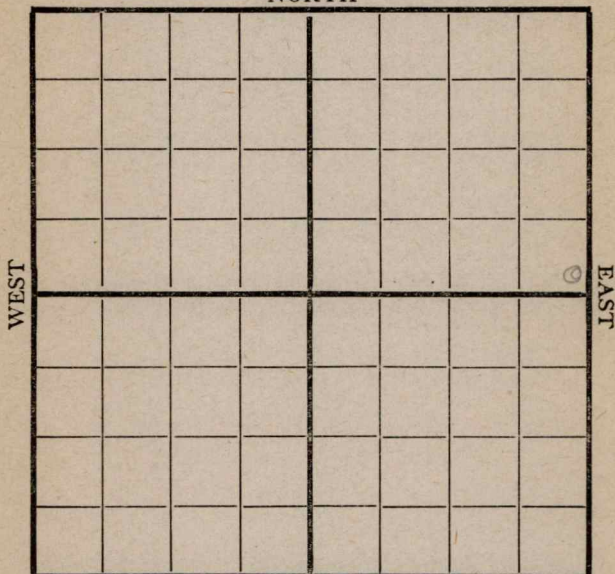

SOUTH

Location _____

Rig up _____

Drilling and Remarks:

1395

RECORD

Cased _____ in., _____ ft.

Sand _____

Gas _____

Oil _____

Total Depth _____

PRODUCTION

1st 24 hrs. Nat. _____

1st 24 hrs. after shot _____

Gas _____ Cu. Ft.

Dry Hole _____

Abandoned _____

Date

7/10

191

S. C. Condit

Scout

Map No. _____ Sec. 1 Twp. 26 R. 4Well No. 44 PorterCenter

Company _____

Contractor _____

NORTH

WEST

EAST

SOUTH

Location _____

Rig up _____

Drilling and Remarks:

1555

RECORD

Cased _____ in., _____ ft.

Sand _____

Gas _____

Oil _____

Total Depth _____

PRODUCTION

1st 24 hrs. Nat. _____

1st 24 hrs. after shot _____

Gas _____ Cu. Ft.

Dry Hole _____

Abandoned _____

Date

7/17 191 8 C. C. C. C. Scout

Map No. _____ Sec. 1 Twp. 26 R. 4

Well No. 44 Porter

_____ Company

_____ Contractor

NORTH

WEST

EAST

SOUTH

Location _____

Rig up _____

Drilling and Remarks:

1605

RECORD

Cased _____ in., _____ ft.

Sand _____

Gas _____

Oil _____

Total Depth _____

PRODUCTION

1st 24 hrs. Nat. _____

1st 24 hrs. after shot _____

Gas _____ Cu. Ft.

Dry Hole _____

Abandoned _____

Date

7/24

191

8

Condy

Scout

Map No. _____ Sec. 1 Twp. 26 R. 4

Well No. 44 Porter


Carter Company

Contractor

NORTH

WEST

EAST

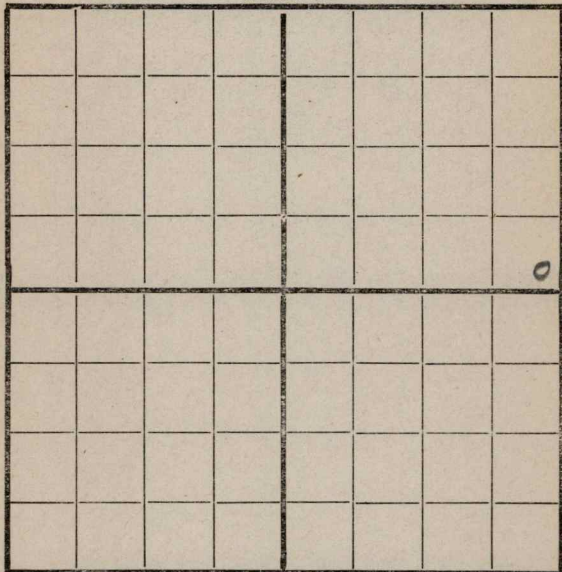

SOUTH

200 SDE

Location _____

Rig up _____

Drilling and Remarks:

Fishing

2140

RECORD

Cased _____ in., _____ ft.

Sand _____

Gas _____

Oil _____

Total Depth _____

PRODUCTION

1st 24 hrs. Nat. _____

1st 24 hrs. after shot _____

Gas _____ Cu. Ft.

Dry Hole _____

Abandoned _____

Date

8/7 1918 Cordell Scout

Map No. _____ Sec. 1 Twp. 26 R. 4

Well No. 44 Porter


Carters Company

Contractor

NORTH

WEST

EAST

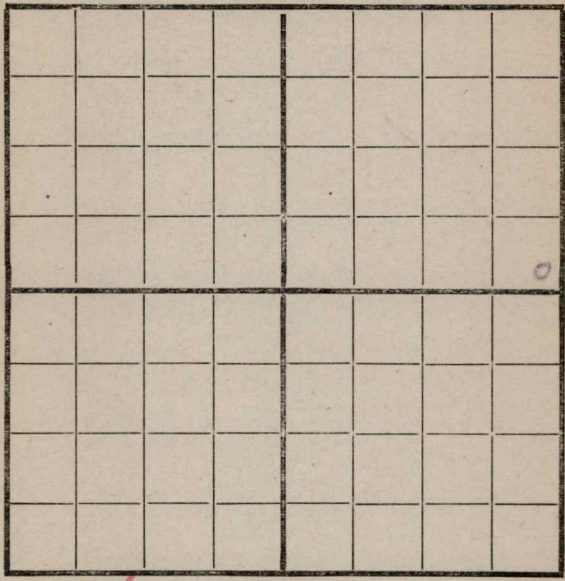

SOUTH

2008
2008

Location _____

Rig up _____

Drilling and Remarks:

2180'

RECORD

Cased _____ in., _____ ft.

Sand _____

Gas _____

Oil _____

Total Depth _____

PRODUCTION

1st 24 hrs. Nat. _____

1st 24 hrs. after shot _____

Gas _____ Cu. Ft.

Dry Hole _____

Abandoned _____

Date 8/1 8 191

G. H. Scout

Map No. _____ Sec. 1 Twp. 26 R. 4

Well No. 44 Porter


Center Company _____

Contractor _____

NORTH

WEST

EAST

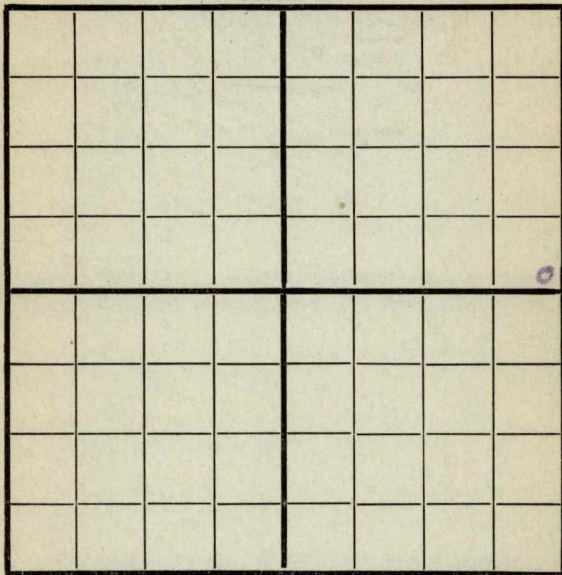

SOUTH

200' D. & C

Location _____

Rig up _____

Drilling and Remarks:

2400'

RECORD

Cased _____ in., _____ ft.

Sand _____

Gas _____

Oil _____

Total Depth _____

PRODUCTION

1st 24 hrs. Nat. _____

1st 24 hrs. after shot _____

Gas _____ Cu. Ft.

Dry Hole _____

Abandoned _____

Date

8/21

1918

Pyle

Scout

K14 MAP NO. KANSAS SEC. 1 TWP. 26 S R. 4 E

WELL NO. 44 Porter

Carter COMPANY

CONTRACTOR

SECTION PLAT

ABANDONED

_____ FT. FROM N. LINE

_____ FT. FROM S. LINE


_____ FT. FROM E. LINE

_____ FT. FROM W. LINE

			0

LOCATION _____

RIG UP _____

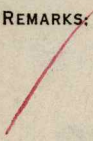DRILLING AND REMARKS: 

RECORD

CASED _____ IN. _____ FT.

SAND _____

GAS _____

OIL _____

TOTAL DEPTH 2583

PRODUCTION

1ST 24 HRS. NAT. _____

1ST 24 HRS. AFTER SHOT _____

GAS _____ CU. FT.

DRY HOLE ☒

ABANDONED ☒

DATE

8/28 1928 SCOUT

Map No. 14 Sec. 1 Twp. 26 R. 4

Well No. 44 Porter

Company

Contractor

NORTH

WEST

EAST

SOUTH

RECORD

Location _____

Cased-----in., -----ft.

Rig up-----

Sand_____

Drilling and Remarks:

Gas _____

Oil_____

Total Depth_____

PRODUCTION

1st 24 hrs. Nat. -----

1st 24 hrs. after shot-----

Gas.....Cu. Ft.

Dry Hole. 2583

Abandoned.....

Date _____

191

Scout