DX 78-1


Greenwood

KANSAS

Section 29 Township 22 Range 13E

Well No. #15 Luthi Unit

Company Geo. Sheehan

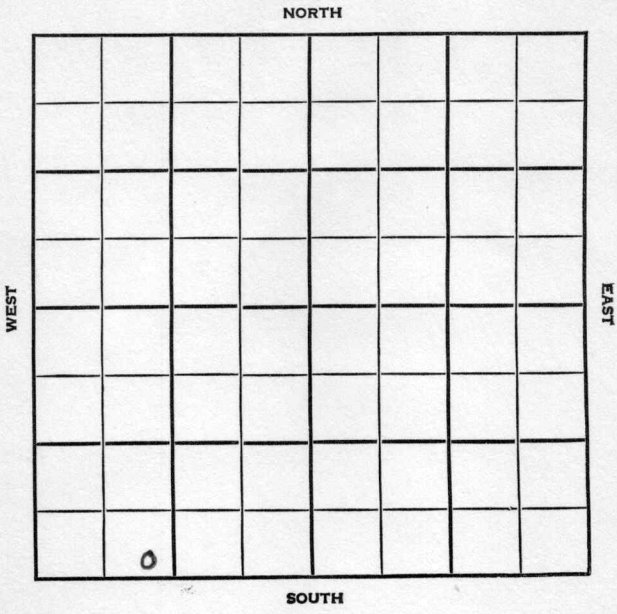

Greenwood KANSAS

SEC.	TWP.	R.
29	22	13 E

WELL NO.

15 Luthi Unit FARM

COMPANY

Geo. Sheehan

CONTRACTOR

Jackman & Jackman
Lamont


_____ Ft. from N. Line

_____ Ft. from S. Line

_____ Ft. from E. Line

_____ Ft. from W. Line

SE SW SW

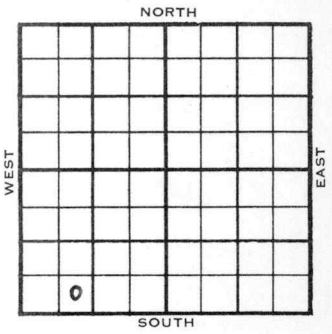

1955	ELEVATION REPORT
6/8	Comm. 6-4-55. 10" @ 81 Drlg. 792'
6/29	TD 1700 Comp. 20 bopd S. Bart. 1684 TD. 1686 COMPLETED

DX-78

FORM 513 REV. SUNRAY

County Greenwood Elev.

Sec. 29 Twp. 22 Rge. 13E

Company Geo. Sheehan

Farm Name Luthi Unit No. 15

TOPS	DEPTH	LOG	DATUM
Anh.			
Tp.			
H.			
Tr.			
Dg.			
B.L.			
L.			
K.C.			
B.K.C.			
Ce.			
C.			
M.			
M.			
K.			
Mz.			
Mo.			
V.			
S.			
S.			
A			
R.			
P€.			
G.			
T.D.			

Loc. in Sec. SE SW SW

Geol.

Contr. Jackman &

Pool Jackman Lamont

FIRST REPORT

JUN 8 '55

0

Date Comm. 6-4-55

10" @ 81 drlg. 792

Co. Lse. No. Sec. T. R.

FORM 513 REV. SUNRAY

County Greenwood Elev.

Sec. 29 Twp. 22 Rge. 13E

Company Geo. Sheehan

Farm Name Luthi Unit No. 15

TOPS	DEPTH	LOG	DATUM
Anh.			
T.p.			
H.			
Tr.			
Dg.			
B.L.			
L.			
K.C.			
B.K.C.			
Ce.			
C.			
M.			
M.			
K.			
Mz.			
Mq.			
V.			
S. Bart	1684		
S.			
A			
R.			
P€.			
G.			
7	1685		
T.D.	1686		

Loc. in Sec. SE SW SW

Geol.

Contr. Jackman & Jackman

Pool Lamont

COMPLETE

Date Comm. 6-4-55

JUN 2 9 1955

10" @ 81 7" @ 1685 TD 1700

Comp. 20 bopd

Co. Lse. No. Sec. T. R.