


Map No. _____ Sec. _____ Twp. 26 R. 4

Well No. 45 _____ Farm _____

Conley Co _____ Company _____

NORTH

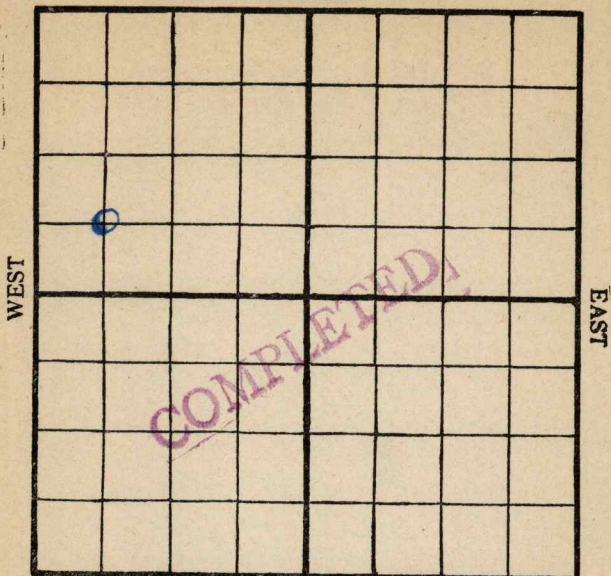

SOUTH

Location _____

Rig Up _____

Drilling Remarks:

Drilling Remarks:

RECORD

PRODUCTION

Cased _____ in. _____ ft.

1st 24 hrs. Nat. _____

Sand _____

1st 24 hrs. after shot _____

Gas _____

Gas _____ cu. ft.

Oil _____

Dry Hole _____

Total Depth _____

Abandoned _____

Map No. 414 Sec. 1 Twp. 26 R. 4Well No. 45 Porter FarmCarter Company

NORTH

WEST

EAST

SOUTH

Location Rig Up

Drilling and remarks

FIRST REPORT

RECORD

Cased in Ft.Sand Gas Oil Total Depth

PRODUCTION

1st 24 hrs. Nat. 1st 24 hrs. after shot Gas Cu. Ft.Dry Hole Abandoned

Date

579, 1918 Carter Scout

Map No. _____ Sec. 1 Twp. 26 R. 4Well No. 45 Porter_____
Compton Company_____
Compton Tools Contractor

NORTH

WEST

EAST

SOUTH

Location _____

Rig up _____

Drilling and Remarks:

895

RECORD

Cased _____ in., _____ ft.

Sand _____

Gas _____

Oil _____

Total Depth _____

PRODUCTION

1st 24 hrs. Nat. _____

1st 24 hrs. after shot _____

Gas _____ Cu. Ft.

Dry Hole _____

Abandoned _____

Date

6/5


191

8 Compton

Scout

Map No. _____ Sec. 1 Twp. 26 R. 4Well No. 45 Porter_____
Porter Company_____
Contractor

NORTH

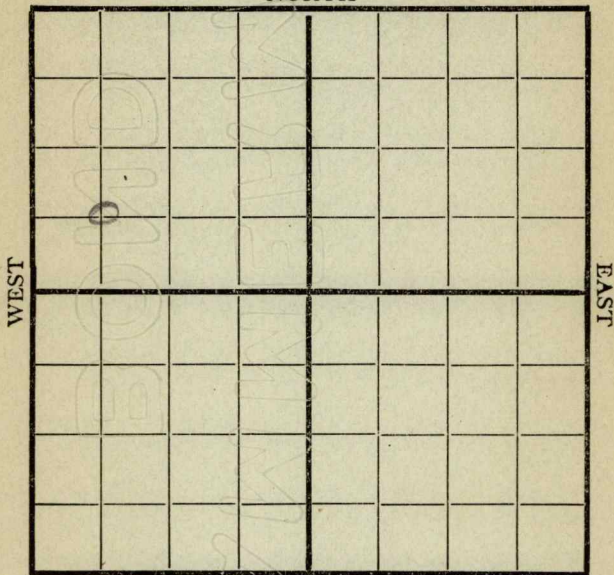

SOUTH

Location _____

Rig up _____

Drilling and Remarks:

975

RECORD

Cased _____ in., _____ ft.

Sand _____

Gas _____

Oil _____

Total Depth _____

PRODUCTION

1st 24 hrs. Nat. _____

1st 24 hrs. after shot _____

Gas _____ Cu. Ft.

Dry Hole _____

Abandoned _____

Date

6/10 1918 C. C. Cuddy Scout


Map No. _____ Sec. 1 Twp. 26 R. 4

Well No. 45 Porter Farm _____

Center Company _____

NORTH

WEST

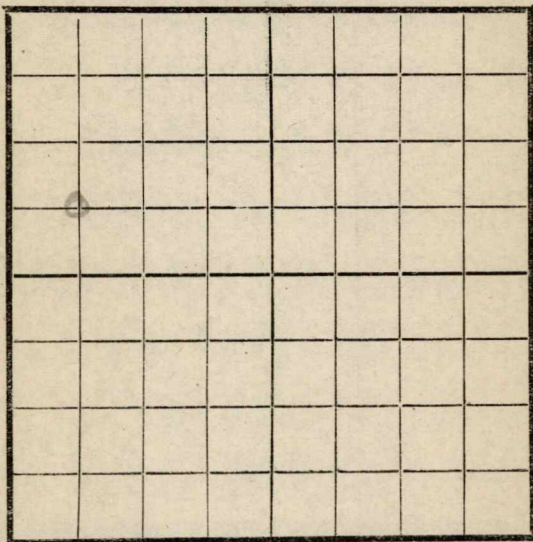

EAST

SOUTH

Location _____

Rig Up _____

Drilling and remarks

1410

RECORD

Cased _____ in _____ Ft

Sand _____

Gas _____

Oil _____

Total Depth _____

PRODUCTION

1st 24 hrs. Nat. _____

1st 24 hrs. after shot _____

Gas _____ Cu. Ft.

Dry Hole _____

Abandoned _____

Date

6/19, 1918

Scout

Map No. _____ Sec. 1 Twp. 26 R. 4Well No. 45 PorterPorter Company

Contractor _____

NORTH

WEST

EAST

SOUTH

Location _____

Rig up _____

Drilling and Remarks:

1605

RECORD

Cased _____ in., _____ ft.

Sand _____

Gas _____

Oil _____

Total Depth _____

PRODUCTION

1st 24 hrs. Nat. _____

1st 24 hrs. after shot _____

Gas _____ Cu. Ft.

Dry Hole _____

Abandoned _____

Date

6/261918Carliff

Scout

Map No. _____ Sec. 1 Twp. 26 R. 4Well No. 450 Porter

_____ Company

_____ Contractor

NORTH

WEST

EAST

SOUTH

Location _____

Rig up _____

Drilling and Remarks:

2060

RECORD

Cased _____ in., _____ ft.

Sand _____

Gas _____

Oil _____

Total Depth _____

PRODUCTION

1st 24 hrs. Nat. _____

1st 24 hrs. after shot _____

Gas _____ Cu. Ft.

Dry Hole _____

Abandoned _____

Date

7/3

191


8 Cooley

Scout

Map No. _____ Sec. 1 Twp. 26 R. 4Well No. 45 PorterPorter Company

Contractor _____

NORTH

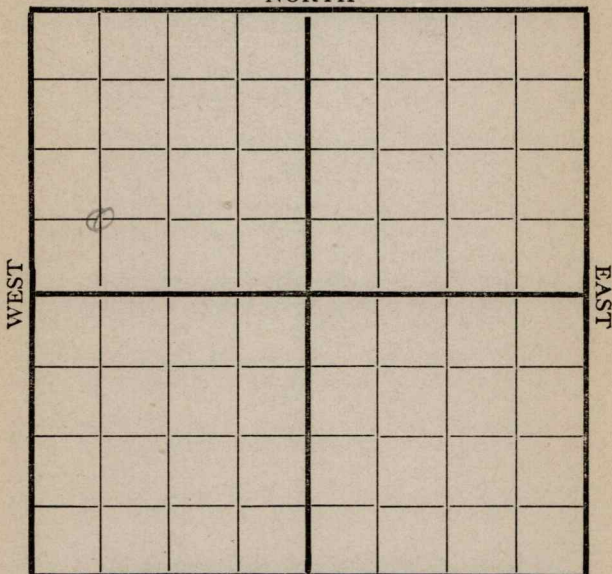

SOUTH

Location _____

Rig up _____

Drilling and Remarks:

2310

RECORD

Cased _____ in., _____ ft.

Sand _____

Gas _____

Oil _____

Total Depth _____

PRODUCTION

1st 24 hrs. Nat. _____

1st 24 hrs. after shot _____

Gas _____ Cu. Ft.

Dry Hole _____

Abandoned _____

Date

7/10

191

S. C. C. C.

Scout

Map No. K14 Sec. 1 Twp. 26 R. 4Well No. 45 PorterCompany Carter

Contractor _____

NORTH

WEST

EAST

COMPLETED

SOUTH

Location _____

Rig up _____

Drilling and Remarks:

Est at
700 Bbe

RECORD

Cased _____ in., _____ ft.

Sand 2390-2414

Gas _____

Oil _____

Total Depth _____

PRODUCTION

1st 24 hrs. Nat. _____

1st 24 hrs. after shot _____

Gas _____ Cu. Ft.

Dry Hole _____

Abandoned _____

Date

7/17 1918 8 Carter Scout