


Map No. _____ Sec. 1 Twp. 26 R. 4

Well No. 46 Porter _____ Farm _____

Carter _____ Company _____

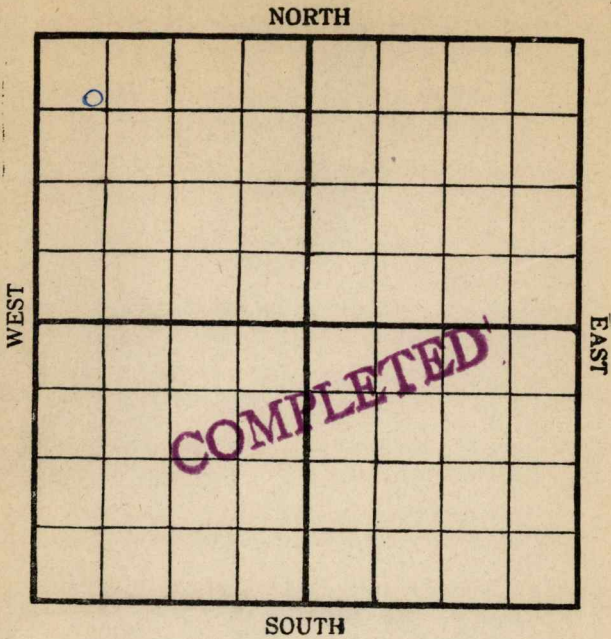

Location _____

Rig Up _____

Drilling Remarks:

Drilling Remarks:

RECORD

PRODUCTION


Cased _____ in. _____ ft.
Sand _____
Gas _____
Oil _____
Total Depth _____

1st 24 hrs. Nat. _____
1st 24 hrs. after shot _____
Gas _____ cu. ft.
Dry Hole _____
Abandoned _____

Map No. K14 Sec. 1 Twp. 26 R. 4
 Well No. 46 Porter Farm
Conlon Company

NORTH

WEST

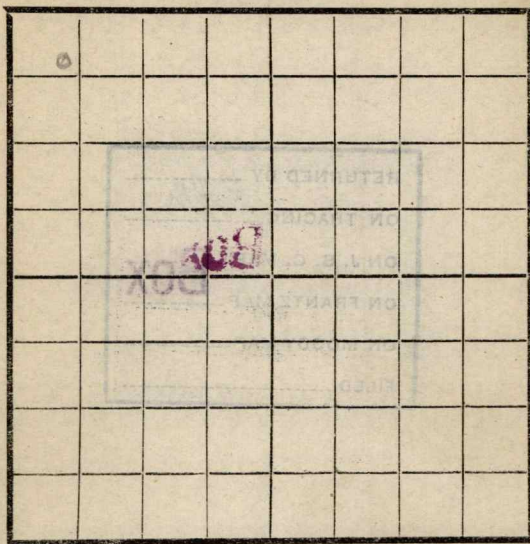

EAST

SOUTH

Location _____
 Rig Up _____
 Drilling and remarks _____

FIRST REPORT

RECORD

Cased _____ in. _____ Ft.
 Sand _____
 Gas _____
 Oil _____
 Total Depth _____

PRODUCTION

1st 24 hrs. Nat. _____
 1st 24 hrs. after shot _____
 Gas _____ Cu. Ft.
 Dry Hole _____
 Abandoned _____

Date

5/9, 1918 Conlon Scout

Map No. _____ Sec. 1 Twp. 26 R. 4Well No. 46 PorterCarter CompanyCompany Tools Contractor

NORTH

WEST

EAST

SOUTH

Location _____

Rig up _____

Drilling and Remarks:

200

RECORD

Cased _____ in., _____ ft.

Sand _____

Gas _____

Oil _____

Total Depth _____

PRODUCTION

1st 24 hrs. Nat. _____

1st 24 hrs. after shot _____

Gas _____ Cu. Ft.

Dry Hole _____

Abandoned _____

Date

6/26

191

PCarter

Scout

Map No. _____ Sec. 1 Twp. 26 R. 4Well No. 46 Porter

_____ Company

_____ Contractor

NORTH

WEST

EAST

SOUTH

Location _____

Rig up _____

Drilling and Remarks:

RECORD

Cased _____ in., _____ ft.

Sand _____

Gas _____

Oil _____

Total Depth _____

PRODUCTION

1st 24 hrs. Nat. _____

1st 24 hrs. after shot _____

Gas _____ Cu. Ft.


Dry Hole _____

Abandoned _____

Date

7/3 191 8 Condy Scout


Map No. _____ Sec. 1 Twp. 26 R. 4
Well No. 46 Porter
Carter _____ Company _____ Contractor

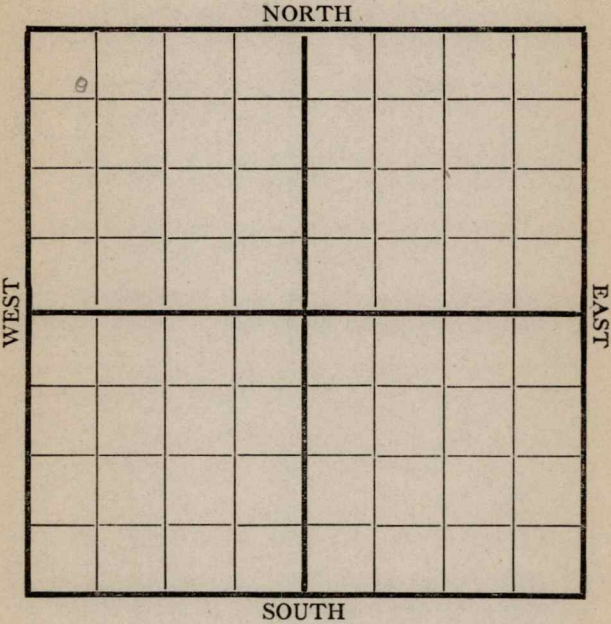

Location _____ Rig up _____ Drilling and Remarks: <u>1190</u>	RECORD
	Cased _____ in., _____ ft.
	Sand _____
	Gas _____
	Oil _____
	Total Depth _____
	PRODUCTION
	1st 24 hrs. Nat. _____
	1st 24 hrs. after shot _____
	Gas _____ Cu. Ft.
	Dry Hole _____
	Abandoned _____

Date 7/10 1918 S. Condit Scout

Map No. _____ Sec. 1 Twp. 26 R. 4
Well No. 46 Porter
Center _____ Company _____
Contractor _____

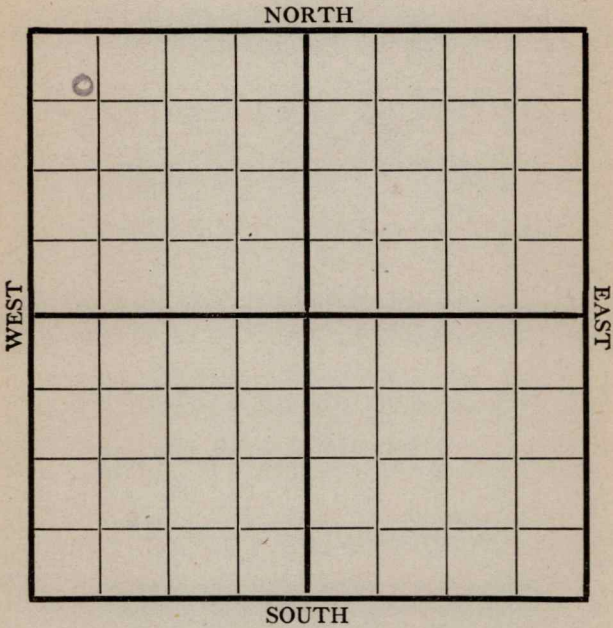

Location _____ Rig up _____ Drilling and Remarks: <u>1460</u>	RECORD Cased _____ in., _____ ft. Sand _____ Gas _____ Oil _____ Total Depth _____ PRODUCTION 1st 24 hrs. Nat. _____ 1st 24 hrs. after shot _____ Gas _____ Cu. Ft. Dry Hole _____ Abandoned _____
--	--

Date 7/17 1918 J. C. Carey Scout

Map No. _____ Sec. 1 Twp. 26 R. 4Well No. 46 Porter

Company _____

Contractor _____

NORTH

WEST

EAST

SOUTH

Location _____

Rig up _____

Drilling and Remarks:

RECORD

Cased _____ in., _____ ft.

Sand _____

Gas _____

Oil _____

Total Depth _____

PRODUCTION

1st 24 hrs. Nat. _____

1st 24 hrs. after shot _____

Gas _____ Cu. Ft.

Dry Hole _____

Abandoned _____

Date

7/241918Conduff

Scout

Map No. _____ Sec. 1 Twp. 26 R. 4Well No. 46 PorterCarter


Company _____

Contractor _____

NORTH

WEST

EAST

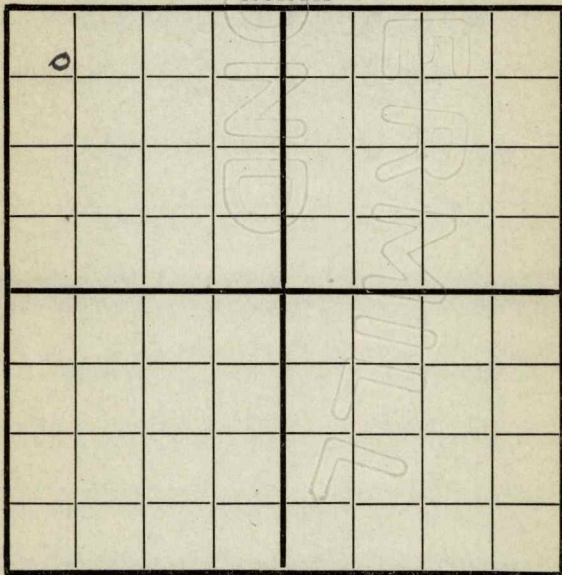

SOUTH

600 S 1/4 L x 600 S 1/4 L

Location _____

Rig up _____

Drilling and Remarks:

1960

RECORD

Cased _____ in., _____ ft.

Sand _____

Gas _____

Oil _____

Total Depth _____

PRODUCTION

1st 24 hrs. Nat. _____

1st 24 hrs. after shot _____

Gas _____ Cu. Ft.

Dry Hole _____

Abandoned _____

Date

7/311918C. Carter


Scout

Map No. _____ Sec. 1 Twp. 26 R. 4Well No. 46 Porter
Center

Company _____

Contractor _____

NORTH

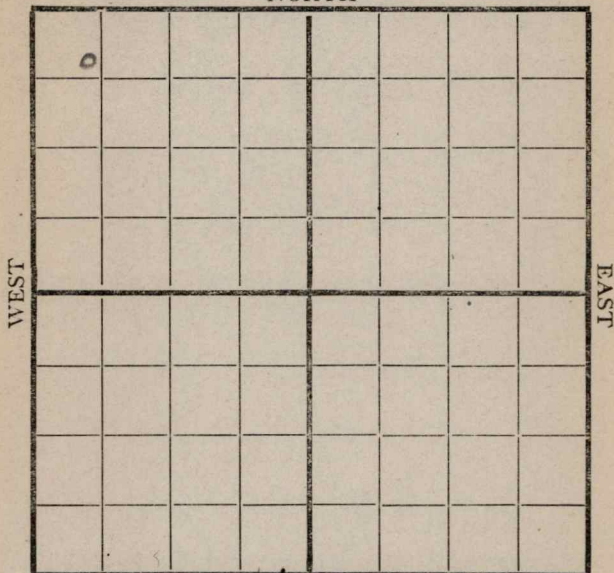

SOUTH

660 NW

Location _____

Rig up _____

Drilling and Remarks:

2300

RECORD

Cased _____ in., _____ ft.

Sand _____

Gas _____

Oil _____

Total Depth _____

PRODUCTION

1st 24 hrs. Nat. _____

1st 24 hrs. after shot _____

Gas _____ Cu. Ft.

Dry Hole _____

Abandoned _____

Date

8/7

191

J. C. Cady

Scout

Map No. K14 Sec. 4 Twp. 26 R. 4Well No. 46 PotterCenter Oil Company

Contractor

NORTH

WEST

EAST

COMPLETED

SOUTH

Location _____

Rig up _____

Drilling and Remarks:

RECORD

Cased _____ in., _____ ft.

Sand 2392-2436

Gas _____

Oil _____

Total Depth _____

PRODUCTION

1st 24 hrs. Nat. 260 bbl

1st 24 hrs. after shot _____

Gas _____ Cu. Ft.

Dry Hole _____

Abandoned _____

Date

191

Scout