


Greenwood

Form 51-5M-4-27-27423

Map No. KANSAS Sec. 29 Twp. 22 R. 13

Well No. 2- Wenzler Farm
Prior-Lockhart-White Eagle Company

NORTH

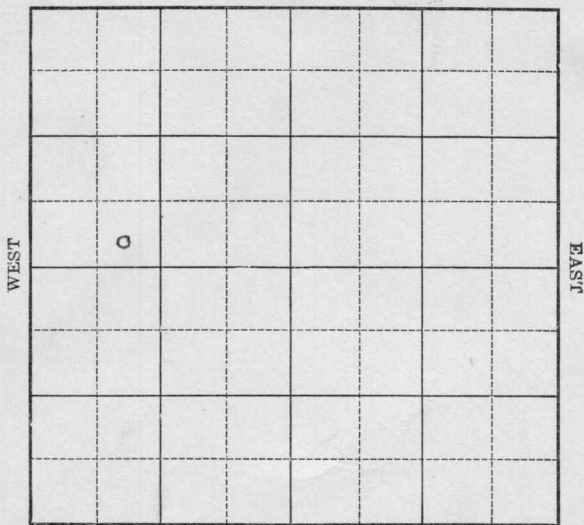

Location _____

Drilling Remarks _____

Rig Up _____

Drilling Remarks _____

RECORD

Cased _____ in. _____ ft.

Sand _____

Gas _____

Oil _____

Total Depth _____

PRODUCTION

1st 24 hrs. Nat. _____

1st 24 hrs. after shot _____

Gas _____ cu. ft.

Dry Hole _____

Abandoned _____

Map No. **KANSAS** Sec. 29 Twp. 22 R. 13

Well No. 2 - Wm 3rd Farm

Pryor-Lockhart-White Eagle Company


Ft. from N. Line

250 Ft. from S. Line

Ft. from E. Line

990 Ft. from W. Line

1928

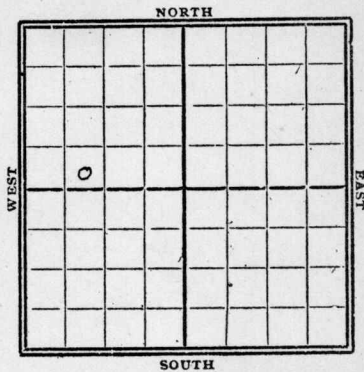

Date _____

REPORT

10/3	Location
------	----------

10/10 Big

10/17	Spalding
-------	----------

10/24 20 rlg 828'

10/31 sand 1656 - 87'

T.D. 1687'

shot 100 qts

60 lbs oil

Sample

S. M. Wood

KANSAS

MAP NO. 29 SEC. 22 TWP. 13

WELL NO. Wingler

Pryor-Hockhart-White Eagle COMPANY

CONTRACTOR

FIRST REPORTS

SECTION PLAT

0			

Ft. FROM N. LINE

250 Ft. FROM S. LINE

Ft. FROM E. LINE

990 Ft. FROM W. LINE

RECORD

LOCATION ✓

CASED _____ IN. _____ FT.

RIG UP _____

SAND _____

DRILLING AND REMARKS:

GAS _____

OIL _____

TOTAL DEPTH _____

PRODUCTION

1ST 24 HRS. NAT. _____

1ST 24 HRS. AFTER SHOT _____

GAS _____ CU. FT.

DRY HOLE _____

ABANDONED _____

DATE

OCT 3 1928

CHAS. L. SHERWOOD

192

SCOUT

20 KANSAS *ing. 29* SEC. *22* TWP. *13* R.

WELL No. *2* *Wingler*
Payer-Rockhart et al COMPANY

CONTRACTOR

SECTION PLAT

COMPLETED

0			

Ft. FROM N. LINE

250 Ft. FROM S. LINE

Ft. FROM E. LINE

990 Ft. FROM W. LINE

LOCATION

RIG UP

DRILLING AND REMARKS:

1007 60 lbs.

RECORD

CASED IN. FT.

SAND *1656-1687*

GAS

OIL

TOTAL DEPTH *1687*

PRODUCTION

1ST 24 HRS. NAT.

1ST 24 HRS. AFTER SHOT

GAS Cu. Ft.

DRY HOLE

ABANDONED

DATE

OCT 31 1900

CHAS. L. SHERWOOD

192

SCOUT