


Map No. _____ Sec. 1 Twp. 26 R. 4
 Well No. 48. Parker Farm _____
Carter Oil Co Company

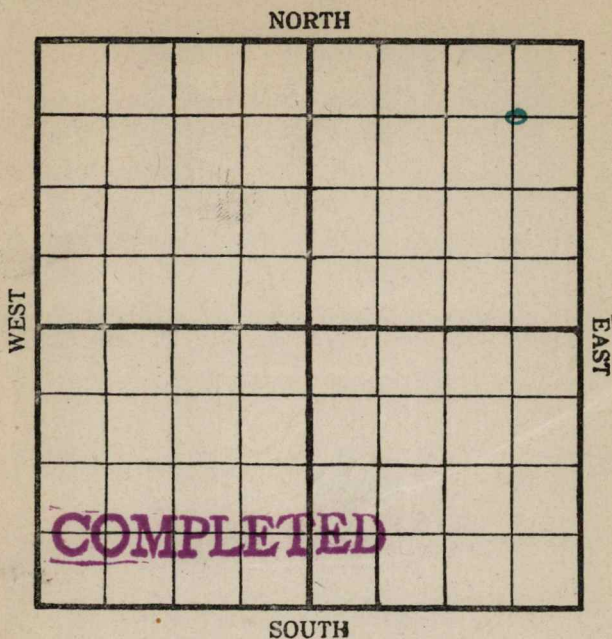

Location _____

Drilling Remarks:

5/15

Rig Up _____

Drilling Remarks:

RECORD

Cased _____ in. _____ ft.
 Sand _____
 Gas _____
 Oil _____
 Total Depth _____


PRODUCTION

1st 24 hrs. Nat. _____
 1st 24 hrs. after shot _____
 Gas _____ cu. ft
 Dry Hole _____
 Abandoned _____

Map No. K14 Sec. 1 Twp. 26 R. 4Well No. 48 Porter FarmCompany Porter

NORTH

WEST

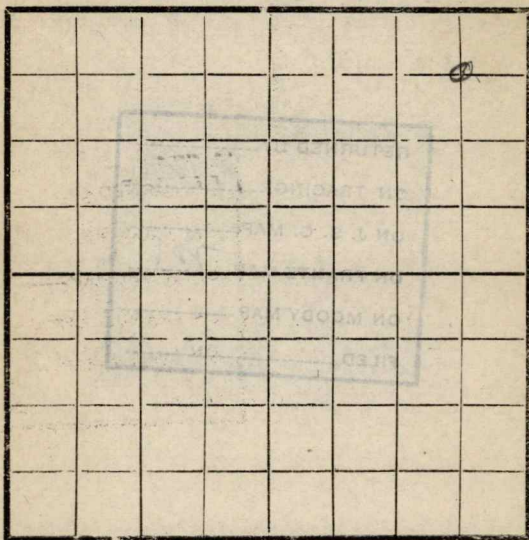

EAST

SOUTH

Location -----

Rig Up -----

Drilling and remarks -----

RECORD

Cased ----- in. ----- Ft.

Sand -----

Gas -----

Oil -----

Total Depth -----

PRODUCTION

1st 24 hrs. Nat. -----

1st 24 hrs. after shot -----

Gas ----- Cu. Ft.

Dry Hole -----

Abandoned -----

Date

5/15, 1918 Porter Scout

FIRST REPORT


Map No. _____ Sec. 1 Twp. 26 R. 4

Well No. 48 Porter Farm _____

_____ Company

NORTH

WEST

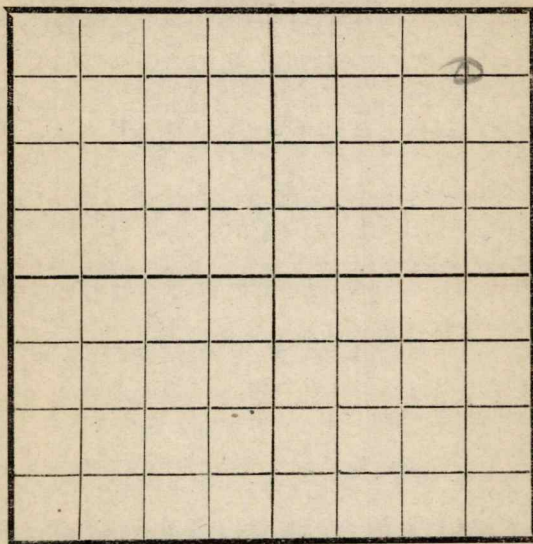

EAST

SOUTH

RECORD

Location _____

Cased _____ in. _____ Ft.

Rig Up _____

Sand _____

Drilling and remarks

Gas _____

Oil _____

Total Depth _____

PRODUCTION

1st 24 hrs. Nat. _____

1st 24 hrs. after shot _____

Gas _____ Cu. Ft.

Dry Hole _____


Abandoned _____

Date

6/19, 1918 Condy Scout

Map No. _____ Sec. 1 Twp. 26 R. 4Well No. 48 PorterPorter _____ Company

_____ Contractor

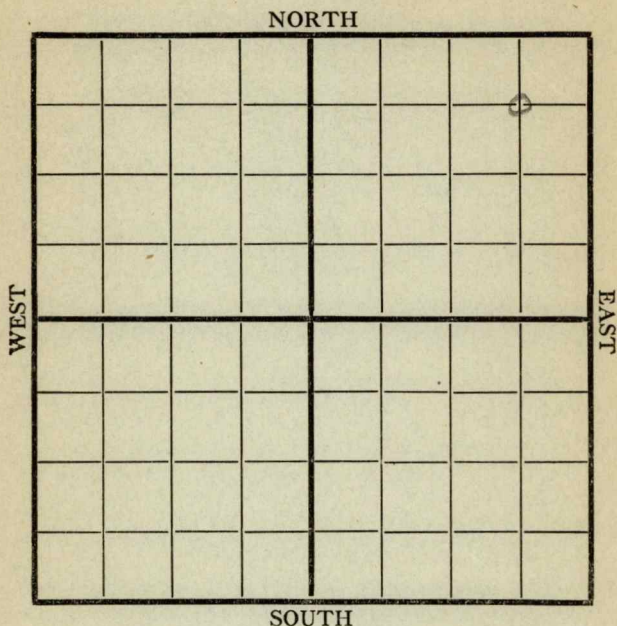

Location _____

Rig up _____

Drilling and Remarks:

765**RECORD**

Cased _____ in., _____ ft.

Sand _____

Gas _____

Oil _____

Total Depth _____

PRODUCTION

1st 24 hrs. Nat. _____

1st 24 hrs. after shot _____

Gas _____ Cu. Ft.

Dry Hole _____

Abandoned _____

Date

6/26 1918 Condy Scout

Map No. _____ Sec. 1 Twp. 26 R. 4Well No. 48 Porter

_____ Company

_____ Contractor

NORTH

WEST

EAST

SOUTH

Location _____

Rig up _____

Drilling and Remarks:

910

RECORD

Cased _____ in., _____ ft.

Sand _____

Gas _____

Oil _____

Total Depth _____

PRODUCTION

1st 24 hrs. Nat. _____

1st 24 hrs. after shot _____

Gas _____ Cu. Ft.

Dry Hole _____

Abandoned _____

Date

7/3

191

S. C. Condy

Scout


Map No. _____ Sec. 1 Twp. 26 R. 4

Well No. 48 Porter

Porter _____ Company

_____ Contractor

NORTH

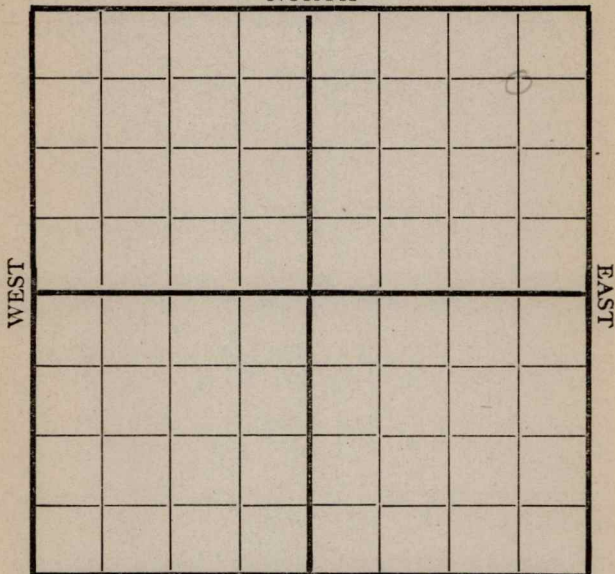

SOUTH

Location _____

Rig up _____

Drilling and Remarks:

1040

RECORD

Cased _____ in., _____ ft.

Sand _____

Gas _____

Oil _____

Total Depth _____

PRODUCTION

1st 24 hrs. Nat. _____

1st 24 hrs. after shot _____

Gas _____ Cu. Ft.

Dry Hole _____

Abandoned _____

Date


7/10

191

S. Condriff

Scout

Map No. _____ Sec. 1 Twp. 26 R. 4
Well No. 48 Porter
Carter _____ Company _____ Contractor _____

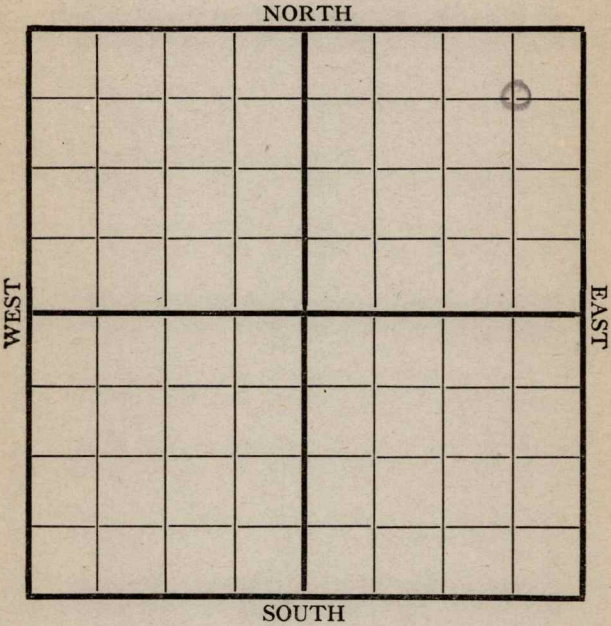

	RECORD	
Location _____	Cased _____ in., _____ ft.	
Rig up _____	Sand _____	
Drilling and Remarks:	Gas _____	
<i>Shut Down</i> <i>1040</i>	Oil _____	
	Total Depth _____	
	PRODUCTION	
	1st 24 hrs. Nat. _____	
	1st 24 hrs. after shot _____	
	Gas _____ Cu. Ft.	
	Dry Hole _____	
	Abandoned _____	

Date 7/17 1918 C. Carter Scout

Map No. _____ Sec. 1 Twp. 26 R. 4Well No. 48 Porter

_____ Company

_____ Contractor

NORTH

WEST

EAST

SOUTH

Location _____

Rig up _____

Drilling and Remarks:

RECORD

Cased _____ in., _____ ft.

Sand _____

Gas _____

Oil _____

Total Depth _____

PRODUCTION

1st 24 hrs. Nat. _____

1st 24 hrs. after shot _____

Gas _____ Cu. Ft.

Dry Hole _____

Abandoned _____

Date

7/24 1918 8 C. C. C. C. Scout


Map No. _____ Sec. 1 Twp. 26 R. 4Well No. 48 Porter
Porter _____ Company _____

Contractor _____

NORTH

WEST

EAST

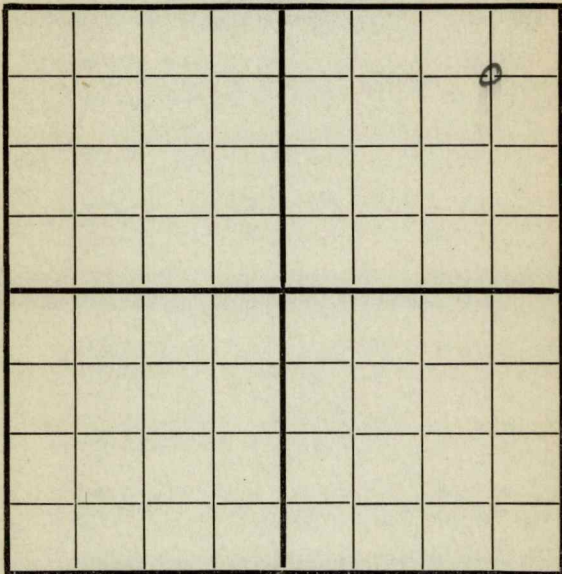

SOUTH

6605 ~~5~~ XL 660 ~~10~~ ER

Location _____

Rig up _____

Drilling and Remarks:

1560

RECORD

Cased _____ in., _____ ft.

Sand _____

Gas _____

Oil _____

Total Depth _____

PRODUCTION

1st 24 hrs. Nat. _____

1st 24 hrs. after shot _____

Gas _____ Cu. Ft.

Dry Hole _____

Abandoned _____

Date

7/31

191

8Carney

Scout

Map No. _____ Sec. 1 Twp. 26 R. 4Well No. 48 PorterCenter


Company _____

Contractor _____

NORTH

WEST

EAST

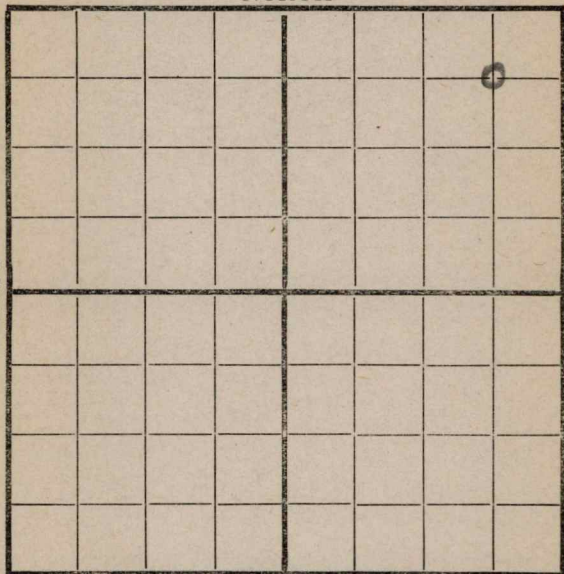

SOUTH

660 N & E

Location _____

Rig up _____

Drilling and Remarks:

82
1560

RECORD

Cased _____ in., _____ ft.

Sand _____

Gas _____

Oil _____

Total Depth _____

PRODUCTION

1st 24 hrs. Nat. _____

1st 24 hrs. after shot _____

Gas _____ Cu. Ft.

Dry Hole _____

Abandoned _____

Date

8/7

191

8 Corder


Scout

Map No. _____ Sec. 1 Twp. 26 R. 4Well No. 48 Pater

_____ Company

_____ Contractor

NORTH

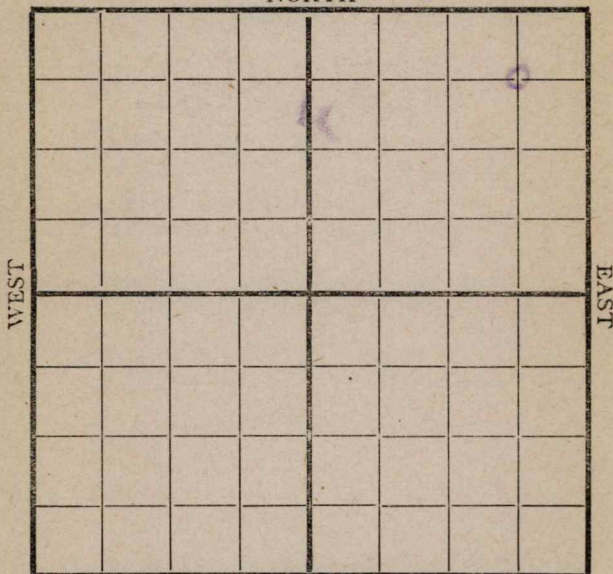

SOUTH

660 N
660 E

Location _____

Rig up _____

Drilling and Remarks:

D. N @

1560'

RECORD

Cased _____ in., _____ ft.

Sand _____

Gas _____

Oil _____

Total Depth _____

PRODUCTION

1st 24 hrs. Nat. _____

1st 24 hrs. after shot _____

Gas _____ Cu. Ft.

Dry Hole _____

Abandoned _____

Date

8/1 1918

Cyle Scout

Map No. _____ Sec. 1 Twp. 26 R. 4

Well No. 48 Porter


Porter Company

Contractor

NORTH

WEST

EAST

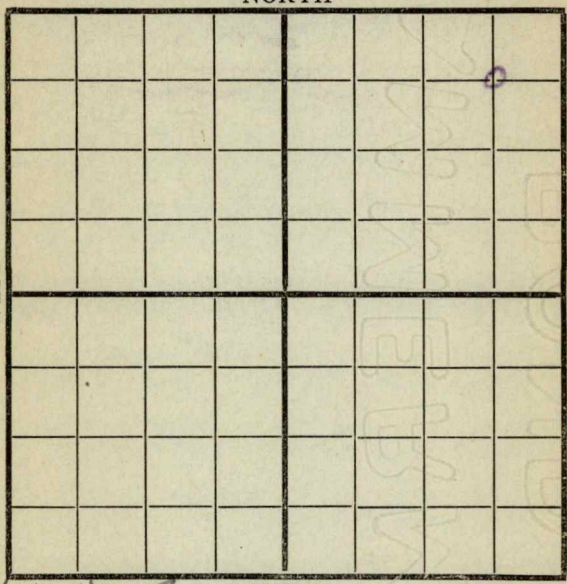

SOUTH

660' N 8 E

Location _____

Rig up _____

Drilling and Remarks:

D 10 @
1560'

RECORD

Cased _____ in., _____ ft.

Sand _____

Gas _____

Oil _____

Total Depth _____

PRODUCTION

1st 24 hrs. Nat. _____

1st 24 hrs. after shot _____

Gas _____ Cu. Ft.

Dry Hole _____

Abandoned _____

Date

8/21 1918

Pyle

Scout

Map No. 1514 Sec. 1 Twp. 26 R. 4Well No. 48 PorterPorter Company

Contractor

NORTH

WEST

EAST

SOUTH

Location _____

Rig up _____

Drilling and Remarks:

Shut down1560

RECORD

Cased _____ in., _____ ft.

Sand _____

Gas _____

Oil _____

Total Depth _____

PRODUCTION

1st 24 hrs. Nat. _____

1st 24 hrs. after shot _____

Gas _____ Cu. Ft.

Dry Hole _____

Abandoned _____

Date

8/28

191

S. Carberry

Scout

Map No. 1514 Sec. 1 Twp. 26 R. 4Well No. 48 PorterCenter Company

Contractor

NORTH

WEST

EAST

COMPLETED

SOUTH

600 420

RECORD

Location _____

Cased _____ in., _____ ft.

Rig up _____

Sand 1556-1560

Drilling and Remarks:

Gas _____

Oil _____

Total Depth _____

PRODUCTION

1st 24 hrs. Nat. _____

1st 24 hrs. after shot _____

Gas _____ Cu. Ft.

Dry Hole _____

Abandoned _____

Date

9/5 191 8 Condit Scout