

Map No. 1 Sec. 30 Twp. 22 R. 13

Well No. 1 Schwab Farm

Unknown Company

NORTH

WEST

EAST

SOUTH

Location _____

Drilling Remarks:

Rig up _____

Drilling Remarks:

RECORD

Cased _____ in. _____ ft.

Sand _____

Gas _____

Oil _____

Total Depth_____

PRODUCTION

1st 24 hrs Nat. _____

1st 24 hrs. after shot_____


Gas _____ cu. ft.

Dry Hole_____

Abandoned _____

Map No. _____ Sec. 30 Twp. 22 R. 13
Well No. 1 Schwab Farm _____
Unknown Company _____

200 Ft. from N. Line
_____ Ft. from S. Line
_____ Ft. from E. Line
200 Ft. from W. Line

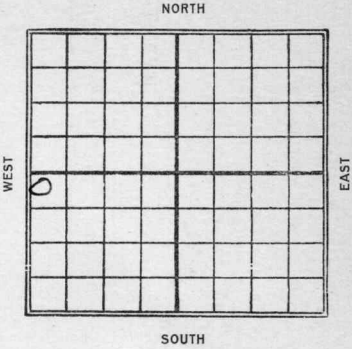

Date
1923
1/12

REPORT

Q & A. 1717'

Map No. *RAE342* Sec. *30* Twp. *22* R. *13*Well No. *1 - Schwal**Unkown* Company

Contractor

ABANDONED**FIRST REPORT****SECTION PLAT***200* Ft. from N. Line

Ft. from S. Line

Ft. from E. Line

200 Ft. from W. Line

<i>φ</i>			

Location

Rig up

Drilling and Remarks:

*1717 LOTA***RECORD**

Cased _____ in., _____ ft.

Sand _____

Gas _____

Oil _____

Total Depth _____

PRODUCTION

1st 24 hrs. Nat. _____

1st 24 hrs. after shot _____

Gas _____ Cu. Ft.

Dry Hole _____

Abandoned _____

Date

JAN 12 1923

191

M. A. BENEAR

Scout