
Form 51—5M—4-27—27423

Map No. ____ Sec. 30 Twp. 22 R. 13

Well No. 1 J. Schwab Farm

Darby etal Company

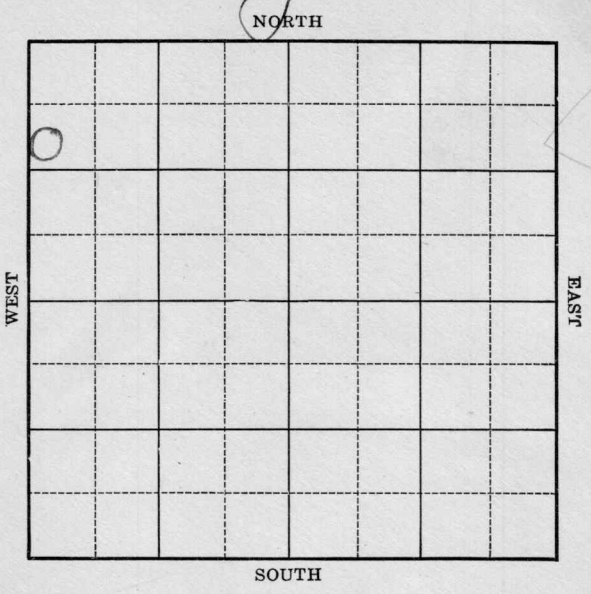

4

Location	Rig Up
Drilling Remarks	Drilling Remarks

RECORD	PRODUCTION
Cased ____ in. ____ ft.	1st 24 hrs. Nat. ____
Sand ____	1st 24 hrs. after shot ____
Gas ____	Gas ____ cu. ft.
Oil ____	Dry Hole ____
Total Depth ____	Abandoned ____

Form 252A—5M—4-27—27425

Map No. ..... Sec. 30 Twp. 22 R. 13

Well No. 1— Schwab Farm


Darby etal Company

991 Ft. from N. Line

..... Ft. from S. Line

..... Ft. from E. Line

114 Ft. from W. Line

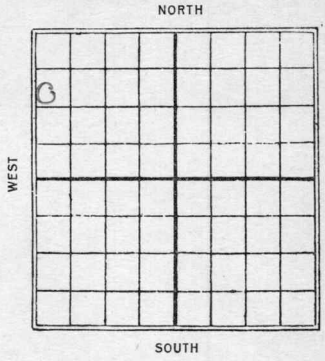

1927

Date	REPORT
10/26	Spudding
11/2	Drlg @ 490'
11/9	" 1550
11/16	1690-1748 T.D. 1751
	220/300 bbls

Form 26—1M Bks.—3-23—11959. Greenwood

KANSAS

Map No._____ Sec. 30 Twp. 22 R. 13E

Well No. 1 Schwab

Darby et al Company

_____ Contractor


SECTION PLAT

991 Ft. from N. Line

_____ Ft. from S. Line

_____ Ft. from E. Line

1114 Ft. from W. Line

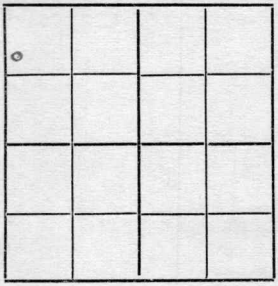

FIRST REPORTS

Location _____

Rig up _____

Drilling and Remarks:

Spudding

RECORD

Cased _____ in., _____ ft.

Sand _____

Gas _____

Oil _____

Total Depth _____

PRODUCTION

1st 24 hrs. Nat. _____

1st 24 hrs. after shot _____

Gas _____ Cu. Ft.

Dry Hole _____

Abandoned _____

Date

OCT 26 1927

CHAS. L. SHERWOOD

_____ 192____. _____ Scout

Form 26—1M Bks.—3-23—11959.

Sherwood

no map KANSAS Map No. _____ Sec. 30 Twp. 22 R. 13

Well No. 1 Schwab

Darby et al Company

_____ Contractor

COMPLETED


991 Ft. from N. Line

_____ Ft. from S. Line

_____ Ft. from E. Line

114 Ft. from W. Line

SECTION PLAT

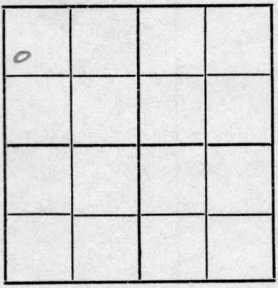

Location _____

Rig up _____

Drilling and Remarks:

22 @ 300 lbs.

RECORD

Cased 7 in., _____ ft.

Sand 1690- 1748

Gas _____

Oil _____

Total Depth 1751

PRODUCTION

1st 24 hrs. Nat. _____

1st 24 hrs. after shot _____

Gas _____ Cu. Ft.

Dry Hole _____

Abandoned _____

Date

NOV 16 1927 192

CHAS. L. SHERWOOD Scout