


Map No. _____ Sec. 1 Twp. 26 R. 4Well No. 12 Abraham Farm __________Empire_____
Company

NORTH

WEST

EAST

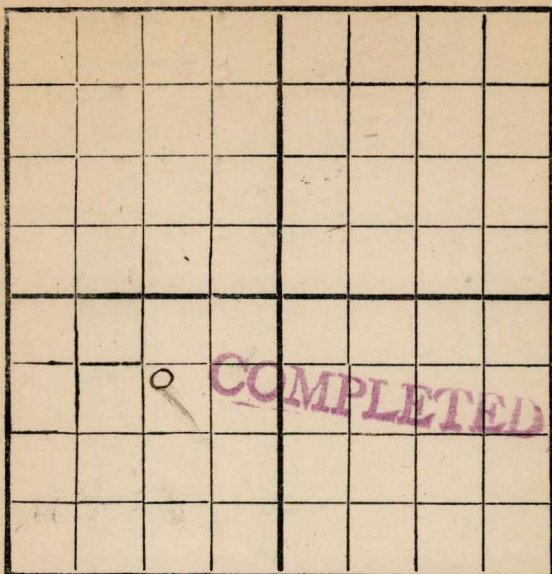

SOUTH

Location _____

Rig Up _____

Drilling Remarks:

Drilling Remarks:

RECORD

Cased _____ in. _____ ft.

Sand _____

Gas _____

Oil _____

Total Depth _____

PRODUCTION

1st 24 hrs. Nat. _____

1st 24 hrs. after shot _____

Gas _____ cu. ft.

Dry Hole _____

Abandoned _____

Map No. _____ Sec. X1 Twp. 26 R. 4

Well No. 12 Abraham Farm _____
Empire Gr Co. Company _____


Contractor _____
SW. Quarter

870 Ft. from N. Line

_____ Ft. from S. Line

1120 Ft. from E. Line

_____ Ft. from W. Line

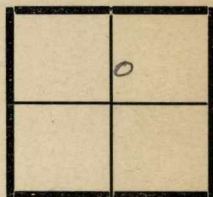

Date 1/19/19

REPORT

10/1 Rig
1/17/19 Drill 2050'
2/20 2380' - 94' - 50' 166'

COMPLETED

Well No. 12 A. Graham

Company

Contractor

WEST

EAST

SOUTH

1120 E

RECORD

Location _____

Rig up ✓ -----

Drilling and Remarks:

Cased _____ in., _____ ft.

Sand.....

Gas -----

Oil _____

Total Depth.....

PRODUCTION

1st 24 hrs. Nat.

1st 24 hrs. after shot-----

Gas _____ Cu. Ft.

Dry Hole

Abandoned.....

Date _____

Pyle

Scout

1919

27

Map No. K14 Sec. 1 Twp. 26 R. 4Well No. 12 AbrahamEmpire Company

Contractor

SECTION PLAT

870 Ft. from N. Line

Ft. from S. Line

1120 Ft. from E. Line

Ft. from W. Line



Location

Rig up

Drilling and Remarks:

RECORD

Cased _____ in., _____ ft.

Sand 2380-94

Gas _____

Oil _____

Total Depth _____

PRODUCTION

1st 24 hrs. Nat. 80 bbls

1st 24 hrs. after shot _____

Gas _____ Cu. Ft.

Dry Hole _____

Abandoned _____

Date

Pyle

2/21 1920

Scout