
Form 51—5M—4-27—27423

Map No. KANSAS Sec. 30 Twp. 22 R. 13

Well No. 5 Schwab Farm

Skelly Oil Company

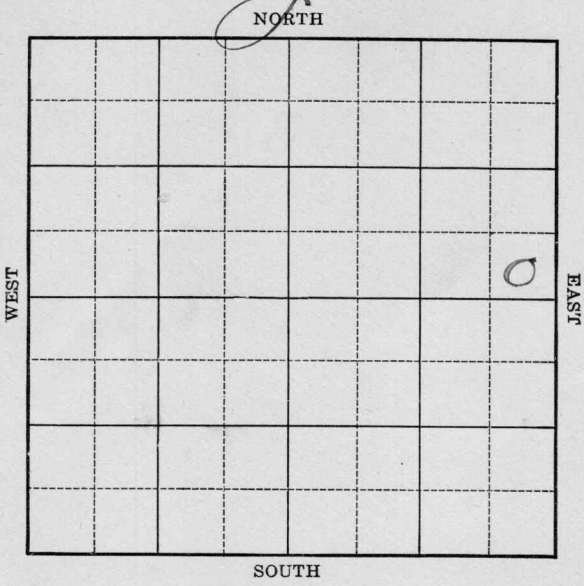

Location	Rig Up
Drilling Remarks	Drilling Remarks


RECORD		PRODUCTION	
Cased	in. ft.	1st 24 hrs. Nat.	
Sand		1st 24 hrs. after shot	
Gas		Gas	cu. ft.
Oil		Dry Hole	
Total Depth		Abandoned	

Form 252A—5M—5-28—Mid-West

Map No. KANSAS Sec. 30 Twp. 22 R. 13

Well No. 5 - Schwab Farm

Skelly Oil Company

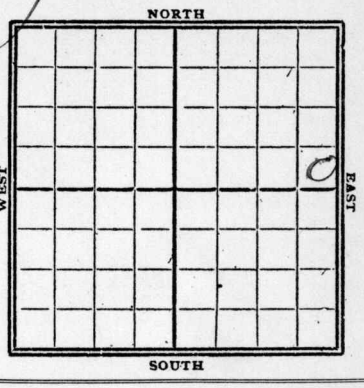

..... Ft. from N. Line

330 Ft. from S. Line

330 Ft. from E. Line

..... Ft. from W. Line

1928

Date	REPORT
7/13	R.O.G.
7/19	Rigg up -
7/26	Drlg 430
8/2	" 860
8/9	" 1200
8/16	Total depth 1693
	sand 1634-1693
	14 @ 225 bbls

FORM 26 250 BKS. 4-26 WESTERN

Sherwood

no map

MAP NO. Sorsoo SEC. 30 TWP. 22 R. 13

WELL NO. 5 Schwab

Skelly Oil Co

COMPANY

CONTRACTOR

FIRST REPORTS


____ FT. FROM N. LINE

330 FT. FROM S. LINE

330 FT. FROM E. LINE

____ FT. FROM W. LINE

SECTION PLAT

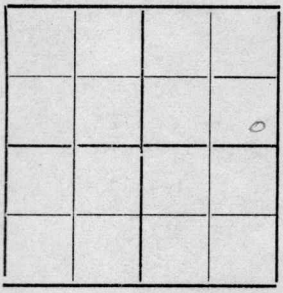

LOCATION ____

RIG UP ____

DRILLING AND REMARKS:

Rot

RECORD

CASED ____ IN., ____ FT.

SAND ____

GAS ____

OIL ____

TOTAL DEPTH ____

PRODUCTION

1ST 24 HRS. NAT. ____

1ST 24 HRS. AFTER SHOT ____

GAS ____ CU. FT.

DRY HOLE ____

ABANDONED ____

DATE 7/13/28 192 Sherwood SCOUT

Form 26—1M Bks.—3-23—11959. B Sherwood

No Drilling KANSAS

Map No. ____ Sec. 30 Twp. 22 R. 13

Well No. 5 Schurb

Skelly Oil Co Company

_____ Contractor

COMPLETED


_____ Ft. from N. Line

330 Ft. from S. Line

330 Ft. from E. Line

_____ Ft. from W. Line

SECTION PLAT

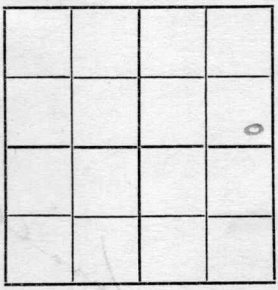

Location _____

Rig up _____

Drilling and Remarks:

140/225 lbs.

RECORD

Cased _____ in., _____ ft.

Sand 1634-1693

Gas _____

Oil _____

Total Depth 1693

PRODUCTION

1st 24 hrs. Nat. _____

1st 24 hrs. after shot _____

Gas _____ Cu. Ft.

Dry Hole _____

Abandoned _____

Date AUG 16 1928

_____ 192__.

CHAS. L. SHERWOOD

_____ Scout