


Map No. 75 Sec. 17 Twp. 23 R. 13
Well No. 4 Bays Farm
Arkansas Fuel Company

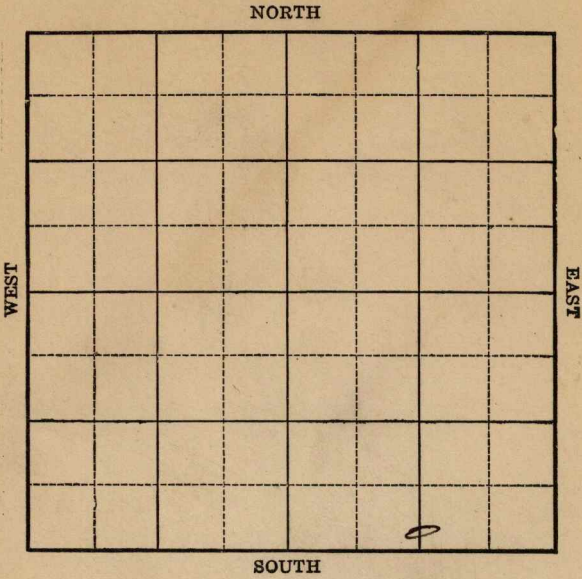

Location _____

Drilling Remarks:

Rig up _____

Drilling Remarks:

RECORD

Cased _____ in. _____ ft.

Sand _____

Gas _____

Oil _____

Total Depth _____

PRODUCTION

1st 24 hrs Nat. _____

1st 24 hrs. after shot _____

Gas _____ cu. ft.

Dry Hole _____

Abandoned _____


Map No. K Sec. 17 Twp. 23 R. 13
 Well No. 4 Bay Farm _____
Ark. Fuel Company _____

_____ Ft. from N. Line

200 Ft. from S. Line

1720 Ft. from E. Line

_____ Ft. from W. Line

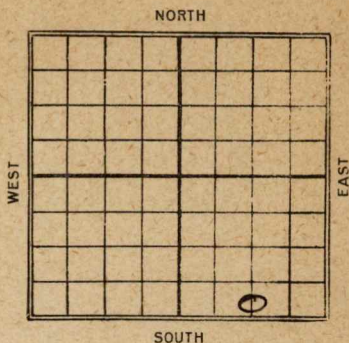

REPORT

Date

6/10 dy 600

7/16 to 1610'

8/6 Top Line 1760 Pay 1770-
1783 40 gts 40 Bbls

Map No. 17 KANSAS Sec. 17 Twp. 23 R. 13

Well No. 4 Bay

Clark Fuel Company

Contractor

FIRST REPORT

SECTION PLAT

_____ Ft. from N. Line

200 Ft. from S. Line

1320 Ft. from E. Line

_____ Ft. from W. Line

Location _____

Rig up _____

Drilling and Remarks:

D. 600

RECORD

Cased _____ in., _____ ft.

Sand _____

Gas _____

Oil _____

Total Depth _____

PRODUCTION

1st 24 hrs. Nat. _____

1st 24 hrs. after shot _____

Gas _____ Cu. Ft.

Dry Hole _____

Abandoned _____

Date JUN 10 1924 M. A. BENEAR

_____ 192 _____ Scout

Map No. **KANSAS** 17 Sec. 17 Twp. 23 R. 13Well No. 4 *Bay's**Ark Full Oil* Company

Contractor

COMPLETED**SECTION PLAT**

-----Ft. from N. Line

200 Ft. from S. Line

1320 Ft. from E. Line

-----Ft. from W. Line

Location -----

Rig up -----

Drilling and Remarks:

Tap L. 1760
Pay 1770-1783
46/40

RECORD

Cased ----- in., ----- ft.

Sand -----

Gas -----

Oil -----

Total Depth -----

PRODUCTION

1st 24 hrs. Nat. -----

1st 24 hrs. after shot -----

Gas ----- Cu. Ft.

Dry Hole -----

Abandoned -----

Date

AUG 6 1924

192

M. A. BENEAR

Scout