
Form 51—5M—4-27—27423

Map No. ____ Sec. 30 Twp. 22 R. 13

Well No. 2 - Schwab Farm

Darby etal Company

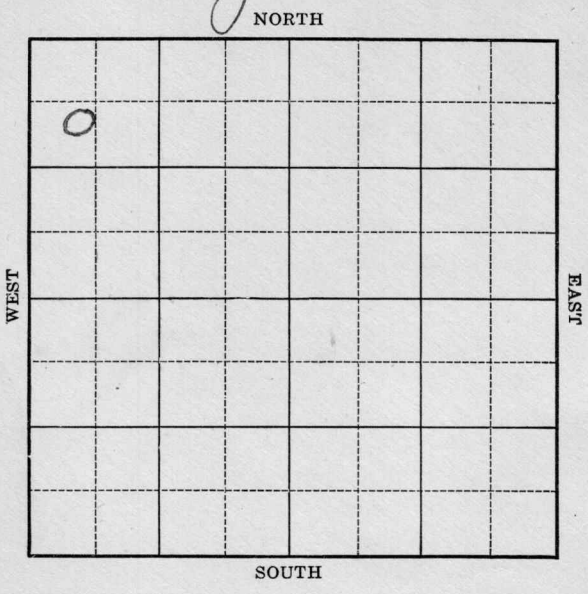

4

Location	Rig Up
Drilling Remarks	Drilling Remarks


RECORD	PRODUCTION
Cased ____ in. ____ ft.	1st 24 hrs. Nat. ____
Sand ____	1st 24 hrs. after shot ____
Gas ____	Gas ____ cu. ft.
Oil ____	Dry Hole ____
Total Depth ____	Abandoned ____

Form 252A—5M—4-27—27425

Map No. ____ Sec. 30 Twp. 22 R. 13

Well No. 2 – Schwab Farm

Darby etal Company

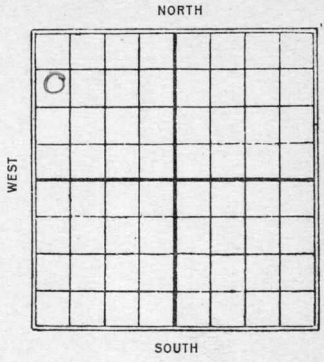

896 Ft. from N. Line

____ Ft. from S. Line

____ Ft. from E. Line

414 Ft. from W. Line

1927

Date	REPORT
10/26	Bldg rig
11/2	Spudding
11/9	Drlg 760
11/16	S.D. 1200 – boiler trouble
11/30	1690 – 1737 – T.D. 1740
	200/280 bbls

Form 26—1M Bks.—3-23—11959. Greenwood

No maps KANSAS E


Map No. ____ Sec. 30 Twp. 22 R. 13

Well No. 2 Schwab

Darby & Gr ____ Company

____ Contractor

SECTION PLAT

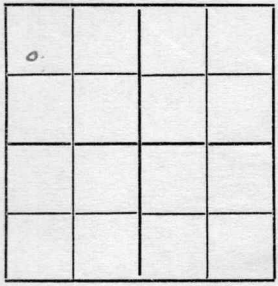

896 Ft. from N. Line

____ Ft. from S. Line

____ Ft. from E. Line

414 Ft. from W. Line

FIRST REPORTS

Location ____

Rig up Hog Rig

Drilling and Remarks:

RECORD

Cased ____ in., ____ ft.

Sand ____

Gas ____

Oil ____

Total Depth ____

PRODUCTION

1st 24 hrs. Nat. ____

1st 24 hrs. after shot ____

Gas ____ Cu. Ft.

Dry Hole ____

Abandoned ____

Date

OCT 26 1927

____ 192__ CHAS. L. SHERWOOD ____ Scout

Form 26—1M Bks.—3-23—11959. Sherwood

no map KANSAS

Map No. ____ Sec. 30 Twp. 22 R. 13

Well No. 2 Schwab

Darby et al ____ Company

____ Contractor

COMPLETED


896 Ft. from N. Line

____ Ft. from S. Line

____ Ft. from E. Line

414 Ft. from W. Line

SECTION PLAT

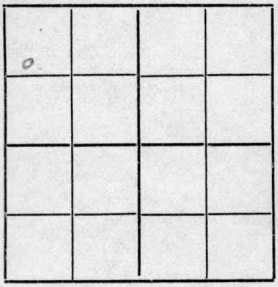

Location ____

Rig up ____

Drilling and Remarks:

207 / 280 lbs.

RECORD

Cased 1 in., ____ ft.

Sand 1690-1737

Gas ____

Oil ____

Total Depth 1740

PRODUCTION

1st 24 hrs. Nat. ____

1st 24 hrs. after shot ____

Gas ____ Cu. Ft.

Dry Hole ____

Abandoned ____

Date

NOV 30 1927

____ 192____.

CHAS. L. SHERWOOD

____ Scout