


Section 1 Township 26 Range 4E

Well No. #2, Fowle

Company T.S. Dustin et al

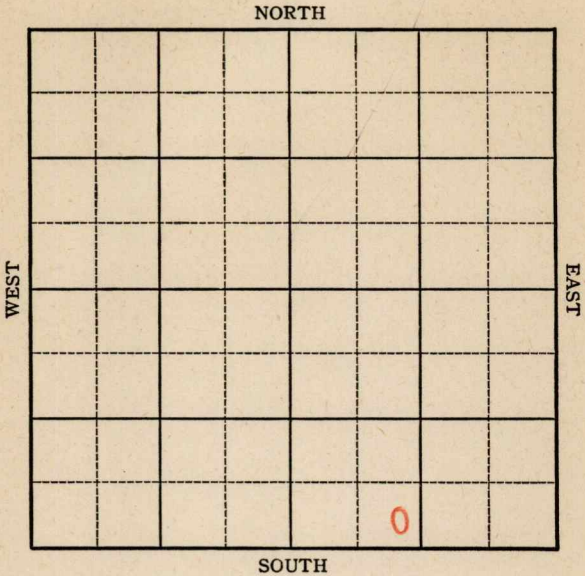

KANSAS

Butler County

Sec. 1 Twp. 26 R. 4EWell No. #2 Fowler Farm

T. S. Dustin et al

Company

Miscellaneous


Ft. from N. Line

500 Ft. from S. Line

Ft. from E. Line

1160 Ft. from W. Line

SE SW SE

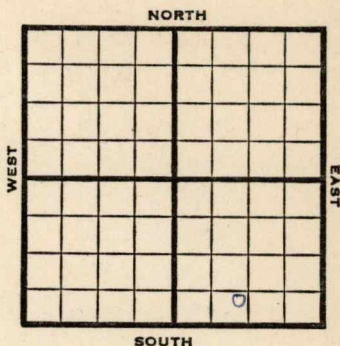

1946

Elev. 1398

REPORT

3/27

Location

4/4

Mach.

4/10

Drlg 850

4/16

15" @ 185, 12" @ 990

Drlg 1700

4/23

10" @ 1720

Lans 1720

KC 2185

Drlg 2200

5/1

Simp 2464-7" @ 2463

Drlg 2500'

5/7

Arb 2494

TD 2532

PB 2520

10 qts 2470-2520 CO

5/14

1000 acid Wtr

5/22

Arb. 2494

TD 2532'

ABANDONED

ANSAS


Kansas Pool Name MiscellaneousMap No. 14 Sec. 1 Twp. 26 R. 4EWell No. 2 FowlerT. S. Dustin et al. Company

FIRST REPORT

Contractor

SE SW SE

SECTION PLAT

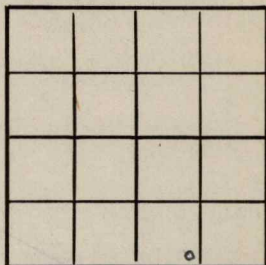 Ft. from N. Line500 Ft. from S. Line Ft. from E. Line1160 Ft. from W. LineButler CountyLocation XRig up

Drilling and Remarks:

RECORD

Cased in., ft.Sand Gas Oil Total Depth

PRODUCTION

1st 24 hrs. Nat. 1st 24 hrs. after shot Gas Cu. Ft.Dry Hole Abandoned

Date

MAR 27 1946

19

S. J. LEWIS

Scout

Kansas Pool Name MiscellaneousMap No. 14 Sec. 1 Twp. 26 R. 4EWell No. 2 FowlerT.S. Dustin etal Company**ABANDONED**

Contractor

E 11398

SE SW SE

SECTION PLAT

 Ft. from N. Line500 Ft. from S. Line Ft. from E. Line1160 Ft. from W. LineButler CountyLocation Rig up

Drilling and Remarks:

See 72494**RECORD**Cased in., ft.Sand Gas Oil Total Depth 2532**PRODUCTION**1st 24 hrs. Nat. 1st 24 hrs. after shot Gas Cu. Ft.Dry Hole Abandoned

Date

MAY 22 1946 19S. J. LEWIS Scout