


Map No. *KANSAS* Sec. *16* Twp. *23* R. *13E*
 Well No. *#1 Spoker* Farm *Shaffer & Howell*
 Company

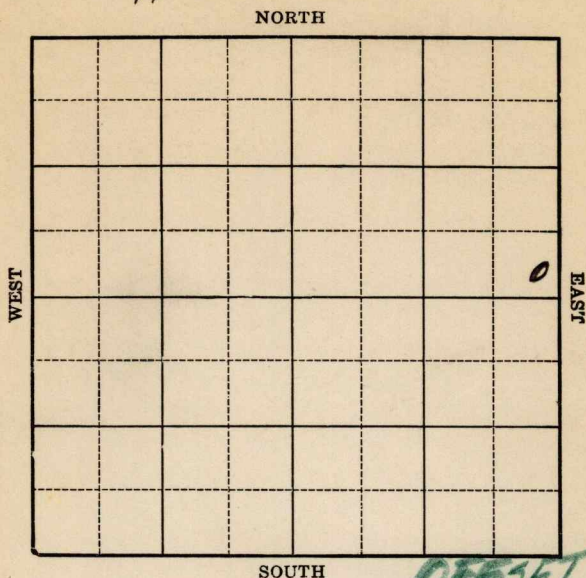

Location _____

Drilling Remarks _____

Rig Up _____

Drilling Remarks _____

RECORD

Cased _____ in. _____ ft.

Sand _____

Gas _____

Oil _____

Total Depth _____

PRODUCTION

1st 24 hrs. Nat. _____

1st 24 hrs. after shot _____

Gas _____ cu. ft.

Dry Hole _____

Abandoned _____

Greenwood

Map No. KANSAS Sec. 16 Twp. 23 R. 13E


Well No. 1 Souder Farm
Shaffer & Howell Company

130 Ft. from N. Line

250 Ft. from S. Line

250 Ft. from E. Line

(OFFSET) Ft. from W. Line

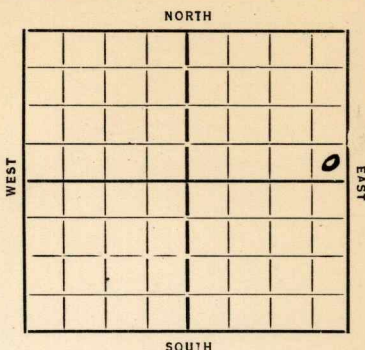

Date 1925

REPORT

1/30 Qty 965
2/6 Burgess 1700-1706 T-1736
30 gts 20 Bbls.

COMPLETED

Map No. 17 Sec. 16 Twp. 23 R. 13EWell No. 1- SonderShaffer + Howell Company

Contractor

FIRST REPORTS

SECTION PLAT

			0

Ft. from N. Line

250 Ft. from S. Line250 Ft. from E. Line

Ft. from W. Line

offset

Location

Rig up

Drilling and Remarks:

RECORD

Cased.....in.,ft.

Sand.....

Gas.....

Oil.....

Total Depth.....

PRODUCTION

1st 24 hrs. Nat.....

1st 24 hrs. after shot.....

Gas.....Cu. Ft.

Dry Hole.....

Abandoned.....

Date

1-30-35 192.....Scou

ORVAL MANNSCHIR

Map No. 17 Sec. 16 Twp. 23 R. 13EWell No. 1- SonderShaffer + Howell Company

Contractor

COMPLETED
CORRECTION

SECTION PLAT

			0

Ft. from N. Line

130 Ft. from S. Line300 Ft. from E. Line

Ft. from W. Line

CORRECTION

feet measurements
formerly reported
250 S 250 E

(offset)

Location

Rig up

Drilling and Remarks:

30 gts20 bbls

RECORD

Cased _____ in., _____ ft.

Sand Buggy 700-1706

Gas _____

Oil _____

Total Depth 1736

PRODUCTION

1st 24 hrs. Nat. _____

1st 24 hrs. after shot _____

Gas _____ Cu. Ft.

Dry Hole _____

Abandoned _____

Date

ORVAL MANNSCHRECK

2-6-35 192

Scout