
Form 51 5M ~~11-25~~ 13896

Map No. K Sec. 15 Twp. 23 R. 13

Well No. 6 R. M. Shadel Farm

Cooden Oil & Gas Company

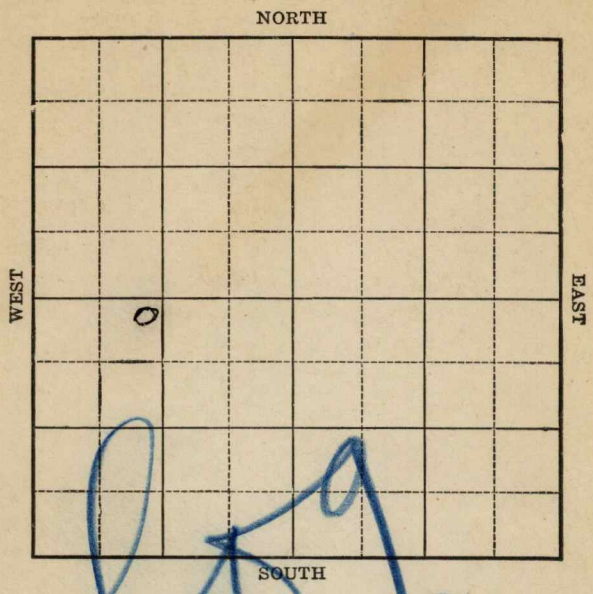

Location

Drilling Remarks:

Rig Up

Drilling Remarks:

RECORD

Cased ____ in. ____ ft.

Sand

Gas

Oil

Total Depth

PRODUCTION

1st 24 hrs. Nat.

1st 24 hrs. after shot

Gas ____ cu. ft.

Dry Hole

Abandoned

Form 252A 5M 2-24 15129

Map No. _____ Sec. 15 Twp. 23 R. 13

Well No. 6 - R. M. Shadel Farm


Gordon Oil & Gas Company

193 Ft. from N. Line

_____ Ft. from S. Line

_____ Ft. from E. Line

870 Ft. from W. Line

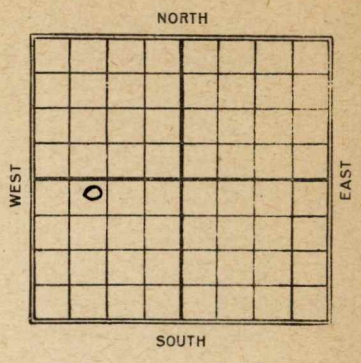

Date	REPORT
1924	
3/7	Location
5/5	IP 1569'
	160 Bbls

m 26—1M Bks.—3-23—11959.

Map No. KANSAS Sec. 15 Twp. 23 R. 13

Well No. 6 - S Hadley

Casden O. & G. Company

Contractor

FIRST REPORT


200 Ft. from N. Line

Ft. from S. Line

Ft. from E. Line

760 Ft. from W. Line

SECTION PLAT

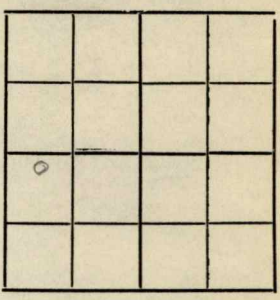

Location

Rig up

Drilling and Remarks:

spud.

RECORD

Cased in., ft.

Sand

Gas

Oil

Total Depth

PRODUCTION

1st 24 hrs. Nat.

1st 24 hrs. after shot

Gas Cu. Ft.

Dry Hole

Abandoned

Date

APR 2 1924

192

M. A. BENEAR

Scout