
FORM 142 REVISED 4 23 1M C. O. & G. CO.

LOCATION NOTICE

TULSA, OKLA. March 7th 192 4

WELL NO. 6 ON A. H. Shadel FARM

WILL BE AS FOLLOWS:

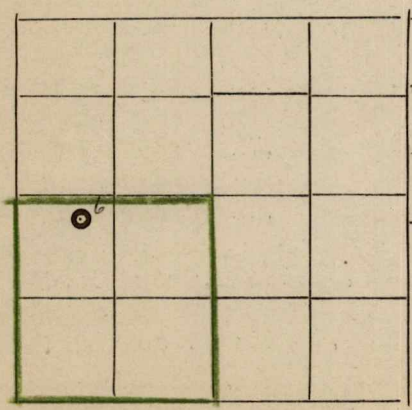

193 FEET FROM NORTH LINE

FEET FROM EAST LINE

FEET FROM SOUTH LINE

620 FEET FROM WEST LINE

500' West of Well #5

IN SW¼ SEC. 15 TWP. 25 RANGE 13

Greenwood COUNTY, STATE OF Kansas

REMARKS:

(SIGNED) G. C. Moody

COPIES TO

DISTRICT SUPT.
ACCOUNTING DEPT.
RENTAL DEPT.
SCOUTING DEPT. ✓
FILE

Returned
Cards
Tracing
I. S. C. map
Kraatz map
Moody map
Prantz lease
Moody plat book