


Map No. _____ Sec. 30 Twp. 22 R. 13
Well No. 3 - Storer Farm _____
John Rogers Company _____

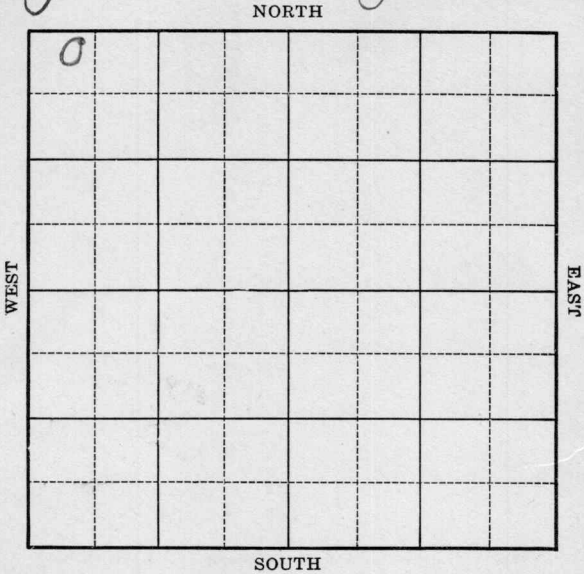

Location _____
Drilling Remarks _____

Rig Up _____
Drilling Remarks _____

RECORD

Cased _____ in. _____ ft.
Sand _____
Gas _____
Oil _____
Total Depth _____

PRODUCTION

1st 24 hrs. Nat. _____
1st 24 hrs. after shot _____
Gas _____ cu. ft.
Dry Hole _____
Abandoned _____


Map No. _____ Sec. 30 Twp. 22 R. 13Well No. 3 - Storrer Farm
John Rogers Company

NORTH

280 Ft. from N. Line

_____ Ft. from S. Line

_____ Ft. from E. Line

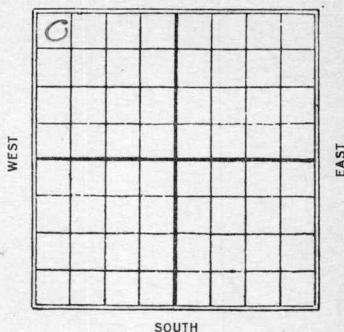589 Ft. from W. Line

SOUTH

1927

Date

REPORT

10/26 Rigging up
11/2 Spudding
11/9 Shut down at 900-
11/16 S.D. 990-
11/30 Abandoned 990'

Greenwood
 Map No. *30* Sec. *22* Twp. *13^E*

Well No. *3* *Storror*

John Rogers. Company

Lot 39 North Contractor

Remont Township

280 Ft. from N. Line

_____ Ft. from S. Line

_____ Ft. from E. Line

589 Ft. from W. Line

SECTION PLAT

0			

FIRST REPORTS

Location _____

Rig up *Rigging up*

Drilling and Remarks:

RECORD

Cased _____ in., _____ ft.

Sand _____

Gas _____

Oil _____

Total Depth _____

PRODUCTION

1st 24 hrs. Nat. _____

1st 24 hrs. after shot _____

Gas _____ Cu. Ft.

Dry Hole _____

Abandoned _____

Date

OCT 26 1927

CHAS. L. SHERWOOD

192

Scout

Sherwood

no KANSAS 30 Twp. 22 R. 13

Well No. 3 Stoner

John Rogers Company

Contractor

COMPLETED

280 Ft. from N. Line

Ft. from S. Line

Ft. from E. Line

889 Ft. from W. Line

ABANDONED

SECTION PLAT

o			

Location

Rig up

Drilling and Remarks:

Abandoned at 990'

RECORD

Cased in., ft.

Sand

Gas

Oil

Total Depth 990

PRODUCTION

1st 24 hrs. Nat.

1st 24 hrs. after shot

Gas Cu. Ft.

Dry Hole

Abandoned ✓

Date

NOV 30 1927

CHAS. L. SHERWOOD

192

Scout