
Form 51—5M—4-27—27423

Map No. ____ Sec. 30 Twp. 22 R. 13

Well No. 2 – Storrer Farm

John Rogers Company

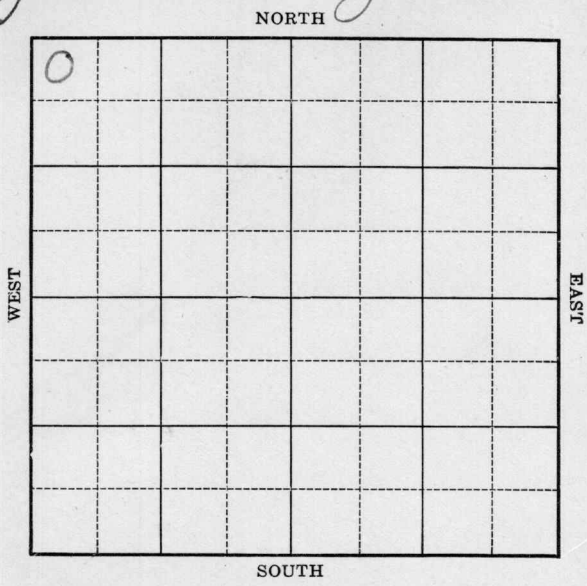

Location	Rig Up
Drilling Remarks	Drilling Remarks

RECORD		PRODUCTION	
Cased	in. ft.	1st 24 hrs. Nat.	
Sand		1st 24 hrs. after shot	
Gas		Gas	cu. ft.
Oil		Dry Hole	
Total Depth		Abandoned	

Form 252A—5M—4-27—27425

Map No. ..... Sec. 30 Twp. 22 R. 13

Well No. 2 – Stoner Farm


John Rogers Company

143 Ft. from N. Line

..... Ft. from S. Line

..... Ft. from E. Line

140 Ft. from W. Line

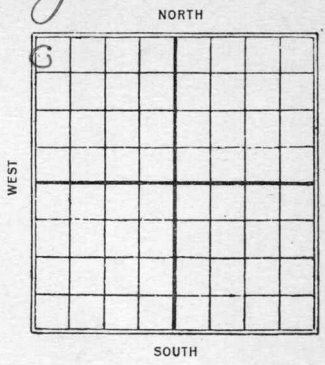

1927

Date	REPORT
10/26	Rigging up
11/2	Drlg 690'
11/9	" 1750'
11/16	Sdy Shale 1705-65 Dr. A. 1775'

Form 26—1M Bks.—3-23—11959. Greenwood

No Map KANSAS

Map No. _____ Sec. 20 Twp. 22 R. 13 E

Well No. 2 Storrer

John Rogers Company

_____ Contractor

Between Lots 426 North Lemont Fourdite

SECTION PLAT

143 Ft. from N. Line

_____ Ft. from S. Line

_____ Ft. from E. Line

140 Ft. from W. Line

FIRST REPORTS

Location _____

Rig up Began rig up.

Drilling and Remarks:

RECORD

Cased _____ in., _____ ft.

Sand _____

Gas _____

Oil _____

Total Depth _____

PRODUCTION

1st 24 hrs. Nat. _____

1st 24 hrs. after shot _____

Gas _____ Cu. Ft.

Dry Hole _____

Abandoned _____

Date

OCT 26 1927 CHAS. L. SHERWOOD

_____ 192____. _____ Scout

Form 26—1M Bks.—3-23—11959. Sherwood

No map KANSAS

Map No.------ Sec. 30 Twp. 22 R. 13

Well No. 2 Stover

John Rogers Company

Contractor

COMPLETED

143 Ft. from N. Line


Ft. from S. Line

Ft. from E. Line

140 Ft. from W. Line

ABANDONED

SECTION PLAT

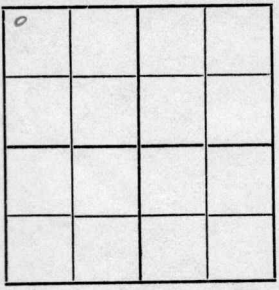

Location

Rig up

Drilling and Remarks:

Shy Shale 1705-65

D 977

1775

RECORD

Cased in., ft.

Sand

Gas

Oil

Total Depth 1775

PRODUCTION

1st 24 hrs. Nat.

1st 24 hrs. after shot

Gas Cu. Ft.

Dry Hole ✓

Abandoned

Date

NOV 16 1927 192

CHAS. L. SHERWOOD Scout