


Map No. **KANSAS** Sec. **14** Twp. **22** R. **13E**
 Well No. **7-A** **Pocumire** Farm
Likman & Braden Company

NORTH

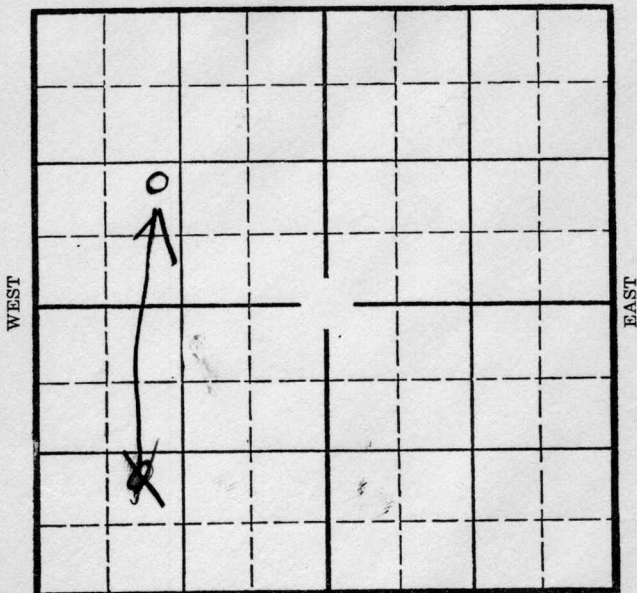

SOUTH

Location _____
 Drilling Remarks _____

Rig Up _____
 Drilling Remarks _____

RECORD

Cased _____ in. _____ ft.
 Sand _____
 Gas _____
 Oil _____
 Total Depth _____

PRODUCTION

1st 24 hrs. Nat. _____
 1st 24 hrs. after shot _____
 Gas _____ cu. ft. _____
 Dry Hole _____
 Abandoned _____

KANSAS

14

Greenwood
Coffee

27

22


13E

Map No. _____ Sec. _____ Twp. _____ R. _____

Well No. 2-A Povenmire Farm

Aikman & Braden Company

NORTH

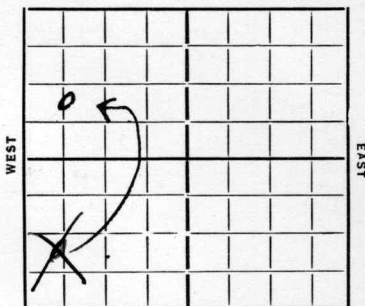

Ft. from N. Line

990
900

Ft. from S. Line

Ft. from E. Line

660
540

Ft. from W. Line

SOUTH

Date 1935

REPORT

6/5 Relg 740
6/13 " 1150
6/20 " 1816
6/26 Sank 1829-49
T 7 1849
25 Bole

COMPLETED

Map No. 20 Sec. 27 Twp. 22 R. 13EWell No. 2A - Roventmire
Aikman + Braden Company

Contractor

FIRST REPORTS

SECTION PLAT

0			

Ft. from N. Line

900 Ft. from S. Line

Ft. from E. Line

540 Ft. from W. Line

RECORD

Location

Cased in., ft.

Rig up

Sand

Drilling and Remarks:

Gas

Oil

Total Depth

PRODUCTION

1st 24 hrs. Nat.

1st 24 hrs. after shot

Gas Cu. Ft.

Dry Hole

Abandoned

Date

5-5-35

192

ORVAL MANNSCHRECK

Scout

Map No. 20 Sec. 14 Twp. 22 R. 13E

Well No. 2A - Povenmire

Alkman + Braden Company

Contractor

CORRECTION


Ft. from N. Line

990 Ft. from S. Line

Ft. from E. Line

660 Ft. from W. Line

SECTION PLAT

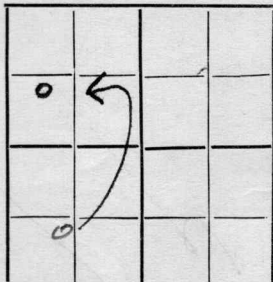

CORRECTION

Location

Rig up

Drilling and Remarks:

Previously reported in

27-22-13E

RECORD

Cased in, ft.

Sand

Gas

Oil

Total Depth

PRODUCTION

1st 24 hrs. Nat.

1st 24 hrs. after shot

Gas Cu. Ft.

Dry Hole

Abandoned

Date

6-19-35 192

ORVAL MANNSCHRECK

Scout

Map No. 20 Sec. 14 Twp. 22 R. 13E

Well No. 2-A, Ponremire

Ripman & Braden Company

Contractor

SECTION PLAT

Ft. from N. Line

990 Ft. from S. Line

Ft. from E. Line

660 Ft. from W. Line

0			

COMPLETED

Location

Rig up

Drilling and Remarks:

25 8 1/2.

RECORD

Cased in, ft.

Sand 1829 - 49

Gas

Oil

Total Depth 1849

PRODUCTION

1st 24 hrs. Nat.

1st 24 hrs. after shot

Gas Cu. Ft.

Dry Hole

Abandoned

Date

ORVAL MANNSCHRECK

7/26/35 192 Scout