


Form 51 5M 8-24 16567
Map No. Kansas Sec. 10 Twp. 23 R. 13
Well No. 21 Schneider Farm
Theta Company

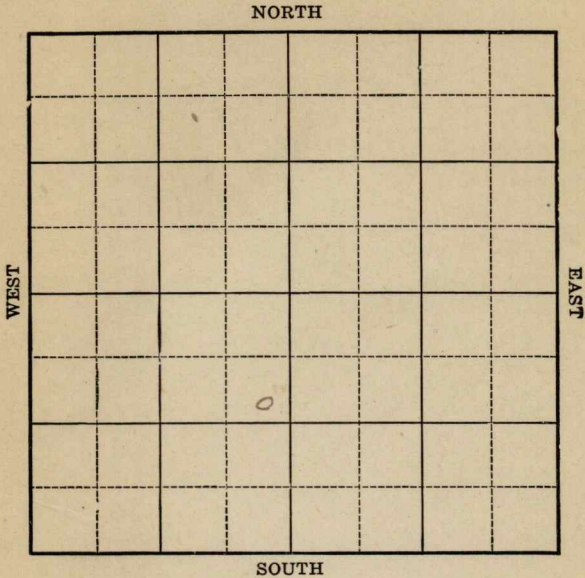

Location _____
Drilling Remarks _____

Rig Up _____
Drilling Remarks _____

RECORD

Cased _____ in. _____ ft.
Sand _____
Gas _____
Oil _____
Total Depth _____

PRODUCTION

1st 24 hrs. Nat. _____
1st. 24 hrs. after shot _____
Gas _____ cu. ft.
Dry Hole _____
Abandoned _____

Map No. Kansas Sec. 10 Twp. 23 R 13


Well No. 21 Schneider Farm
Theta Company

1120 Ft. from N. Line

_____ Ft. from S. Line

200 Ft. from E. Line

_____ Ft. from W. Line

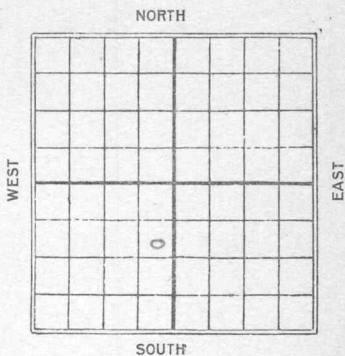

Date
1925

REPORT

3/1 Location
4/17 Abandoned 2200

Map No. 13 Sec. 10 Twp. 23 R. 13
 Well No. 21 Schneider
Theta oil Co Company

COMPLETED

SECTION PLAT

1120 Ft. from N. Line

_____ Ft. from S. Line

200 Ft. from E. Line

_____ Ft. from W. Line

ABANDONED

Location _____

Rig up _____

Drilling and Remarks:

gap line 1768

dry & abd

2D 2200'

RECORD

Cased _____ in., _____ ft.

Sand _____

Gas _____

Oil _____

Total Depth 2200'

PRODUCTION

1st 24 hrs. Nat. _____

1st 24 hrs. after shot _____

Gas _____ Cu. Ft.

Dry Hole ☒

Abandoned ☒

Date

APR 17 1925

192

Chas. L. Sherwood
 Scout

Map No. 17 KANSAS Sec. 10 Twp. 23 R. 13

Well No. 21 Schneider

Theta Company

Contractor

FIRST REPORT

1120 Ft. from N. Line

1 Ft. from S. Line

200' Ft. from E. Line

_____ Ft. from W. Line

SECTION PLAT

Location ✓✓

Rig up _____

Drilling and Remarks:

RECORD

Cased _____ in., _____ ft.

Sand _____

Gas _____

Oil _____

Total Depth _____

PRODUCTION

1st 24 hrs. Nat. _____

1st 24 hrs. after shot _____

Gas _____ Cu. Ft.

Dry Hole _____

Abandoned _____

Date

3/1 1925

M. A. BENEAR Scout