


Coffey

Form 51-5M-2-29-34703

Map No. KANSAS Sec. 14 Twp. 22 R. 13^E

Well No. 1-B. Pavemire Farm
Cushman & Baker Company

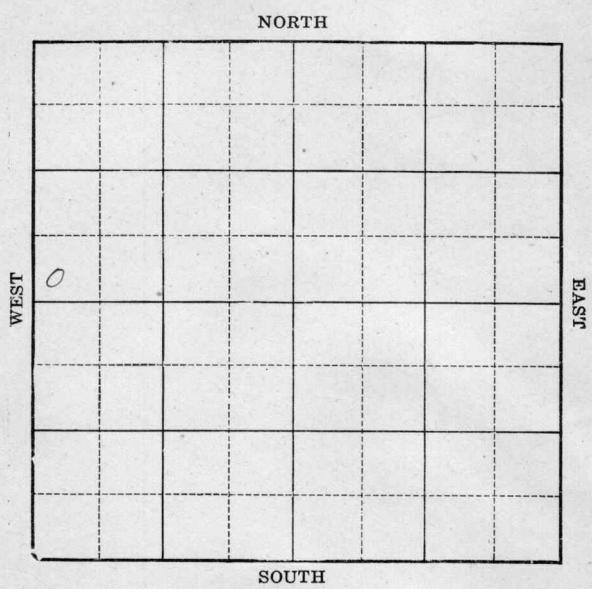

Location _____
Drilling Remarks _____

Rig Up _____
Drilling Remarks _____

RECORD

Cased _____ in. _____ ft.
Sand _____
Gas _____
Oil _____
Total Depth _____

PRODUCTION

1st 24 hrs. Nat. _____
1st 24 hrs. after shot _____
Gas _____ cu. ft.
Dry Hole _____
Abandoned _____

Well No. 1-19 Pavemire Farm

Well No. 1-B. Pavemire Farm
Nickmen & Baker Company

NORTH


Ft. from N. Line

200 Ft. from S. Line

Ft. from E. Line

200 Ft. from W. Line

1931

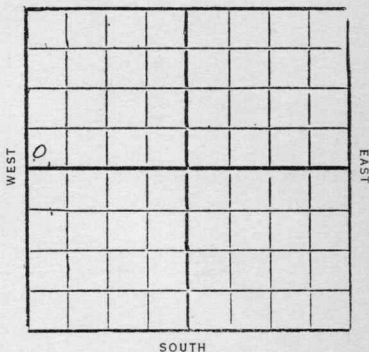

Date _____

REPORT

10/21 Drlg 750'
10/28 8¹¹ - 1577
drlg 1655
11/4 Land 1835-57
shot 60 gts
Olg out
11/10 Land 1835-57
FD. 1857
shot 60 gt
50 bbl oil
Comp.

20 KANSAS Sec. 14 Twp. 22 R. 13^E
 Well No. 1 B. Pauemire
 Aikman & Baker Company

Contractor

FIRST REPORTS

SECTION PLAT

0			

Ft. from N. Line

200 Ft. from S. Line

Ft. from E. Line

200 Ft. from W. Line

Location

Rig up

Drilling and Remarks:

Btg 750'

RECORD

Cased in., ft.

Sand

Gas

Oil

Total Depth

PRODUCTION

1st 24 hrs. Nat.

1st 24 hrs. after shot

Gas Cu. Ft.

Dry Hole

Abandoned

Date

OCT 21 1931

192

CHAS. L. SHERWOOD

Scout

Copper

E

20 KANSAS Map No. Sec. 14 Twp. 22 R. 13

Well No. 1 B. Pavemire
Dickman & Barker Company

Contractor

COMPLETED

SECTION PLAT

0			

Ft. from N. Line

200 Ft. from S. Line

Ft. from E. Line

200 Ft. from W. Line

Location

Rig up

Drilling and Remarks:

60/50 Bbs.

RECORD

Cased in. ft.

Sand 1835-1857

Gas

Oil

Total Depth 1857

PRODUCTION

1st 24 hrs. Nat.

1st 24 hrs. after shot

Gas Cu. Ft.

Dry Hole

Abandoned

Date

NOV 10 1931

192

CHAS. L. SHERWOOD

Scout