
Form 51—5M—3-26—22544

Greenwood

Map No. ____ Sec. 15 Twp. 22 R. 13

Well No. 1 Clark Farm

D. D. Nolan Company

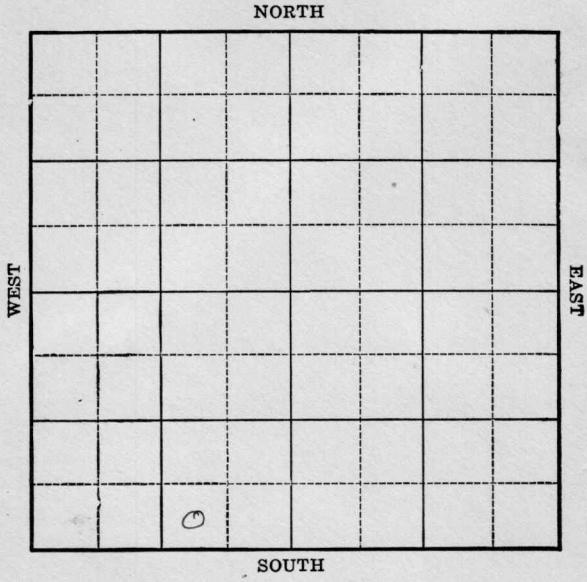

Location ____

Drilling Remarks

Rig Up ____

Drilling Remarks

RECORD

Cased ____ in. ____ ft.

Sand ____

Gas ____

Oil ____

Total Depth ____

PRODUCTION

1st 24 hrs. Nat. ____

1st 24 hrs. after shot ____

Gas ____ cu. ft.

Dry Hole ____


Abandoned ____

Form 252A—5M—11-25—20913 Greenwood

Map No. Kans Sec. 15 Twp. 22 R. 13

Well No. 1 Clark Farm

D. D. Nolan Company

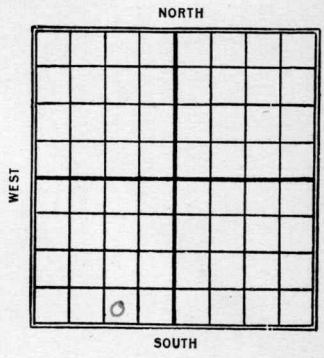

____ Ft. from N. Line

830 Ft. from S. Line

990 Ft. from E. Line

____ Ft. from W. Line

1926

Date	REPORT
9/22	Location
9/29	same
10/3	rig
10/7	Rlg gin rig
11/11	Drlg 500
11/17	" 1160
11/23	S D 1610 for Casing
12/8	—
12/15	Drlg 1750'
12/22	no sand. Top lime 1835 Drlg 1990
12/30	S.D. 1990
1927	
1/6	Top 2nd break 2170 Drlg 2178
1/12	D. & A. 2282

Form 26—1M Bks.—8-23—11959.

Greenwood

normal KANSAS

Map No. 1 Sec. 15 Twp. 22 R. 13

Well No. 1 Clark

D. D. Nolan Company

Contractor

FIRST REPORTS

SECTION PLAT

	o		

330 Ft. from N. Line

Ft. from S. Line

990 Ft. from E. Line

Ft. from W. Line

Location ✓

Rig up

Drilling and Remarks:

RECORD

Cased in., ft.

Sand

Gas

Oil

Total Depth

PRODUCTION

1st 24 hrs. Nat.

1st 24 hrs. after shot

Gas Cu. Ft.

Dry Hole

Abandoned

Date

SEP 22 1926

192


CHAS. L. SHERWOOD Scout

Form 32 S.C.O.P.Co.—1M Bks.—2-25—18417 Glenwood

Map No. KANSAS Sec. 15 Twp. 22 R. 13 E

Well No. 1 Clark Farm

D. D. Nolan Company

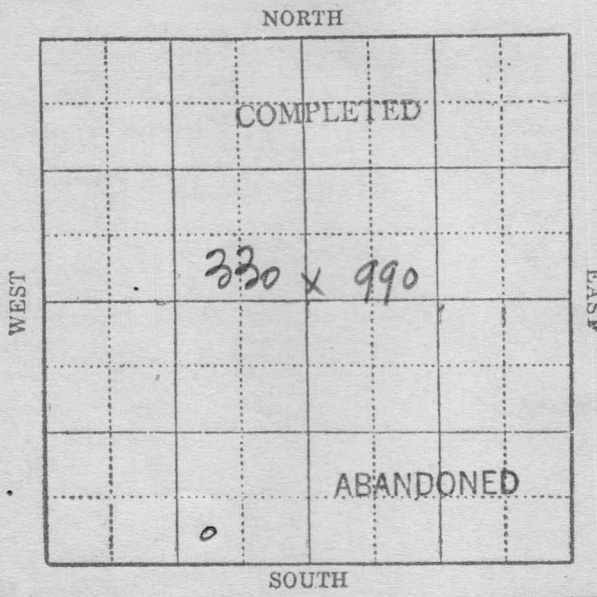

Location

Rig up

Drilling and Remarks:

Top Lime 1855'

AFW 2275'

DQG 2282'

RECORD

Cased in., ft.

Sand

Gas

Oil

Total Depth 2282

PRODUCTION

1st 24 hrs. Nat.

1st 24 hrs. after shot

Gas Cu. Ft.

Dry Hole ✓

Abandoned ✓

Date JAN 2 1927 CHAS. L. SHERWOOD

192 Scout