


Section 15 Township 22 Range 13E

Well No. #1 Povemire

Company C.A. Aikman

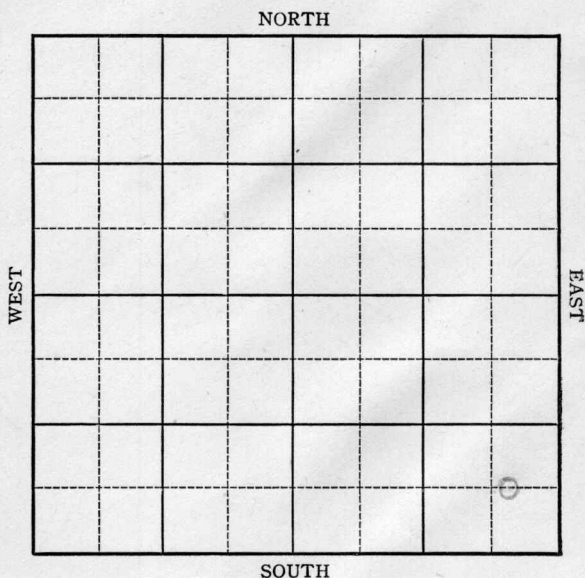

Sec. 15 Twp. 22 R. 13E

Well No. #1 Povemire Farm
C.A. Aidman Company


Miscellaneous

 Ft. from N. Line

660 Ft. from S. Line

500 Ft. from E. Line

 Ft. from W. Line

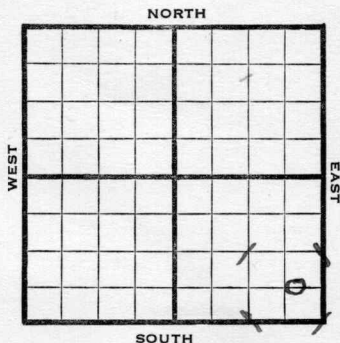

1944

REPORT

4/26

Machine

5/10

Drlg. 250

5/17

Drlg. 550

5/24

10" @ 720

Drlg. 815

5/31

SD

6/7

8" @ 1040

6" @ 1720-1724 SD

6/21

Miss 1830

6" @ 1830

T.D. 1835

ABANDONED

Pool Name Miscellaneous

KANSAS
 Map No. 20 Sec. 15 Twp. 22 R. 13E

Well No. 1 povemire

C. A. Aikman


Company

FIRST REPORT

Contractor

C SE SE

SECTION PLAT

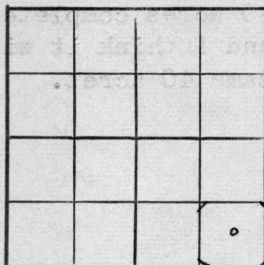

Ft. from N. Line

660

Ft. from S. Line

500

Ft. from E. Line

Ft. from W. Line

Greenwood County

Location

Rig up

Drilling and Remarks:

Machine

RECORD

Cased _____ in., _____ ft.

Sand _____

Gas _____

Oil _____

Total Depth _____

PRODUCTION

1st 24 hrs. Nat. _____

1st 24 hrs. after shot _____

Gas _____ Cu. Ft.

Dry Hole _____

Abandoned _____


Date

APR 26 1944 19

S. J. LEWIS Scout

show #1
in this 40 acres
a dry hole

We already show a #1 well in this
40 acres completed. Check your map
and I think it will show a No 1 in this
same 40 acres. Advise
Sam

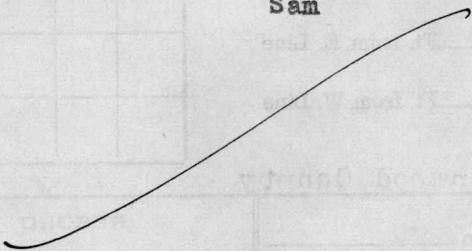

Misc. Small Maps	<i>Ona</i>
Cards	<i>Madge</i>
Tracing	
ance Map	
rborough Map	
dy Map	
ogical Dept.	
ly Plat Book	

Reported #1 Plugged
and they are calling
the No. 1

Sandy.

Pool Name MiscellaneousMap No. 20 Sec. 15 Twp. 22 R. 13EWell No. 1 PovemireC. A. Aikman CompanyABANDONED Contractor

C SE SE

SECTION PLAT

			o

Ft. from N. Line

660 Ft. from S. Line500 Ft. from E. Line

Ft. from W. Line

Greenwood County

Location _____

Rig up _____

Drilling and Remarks:

*Miss 1830**6 " C / 1830*

RECORD

Cased _____ in., _____ ft.

Sand _____

Gas _____

Oil _____

Total Depth 1835

PRODUCTION

1st 24 hrs. Nat. _____

1st 24 hrs. after shot _____

Gas _____ Cu. Ft.

Dry Hole _____

Abandoned _____

Date

JUN 21 1944 19 S. J. LEWIS Scout