
Form 51 5M 11-23 13896

Map No. Kansas Sec. 17 Twp. 22 R. 13

Well No. 1 Kegler Farm

Empire G+F. Company

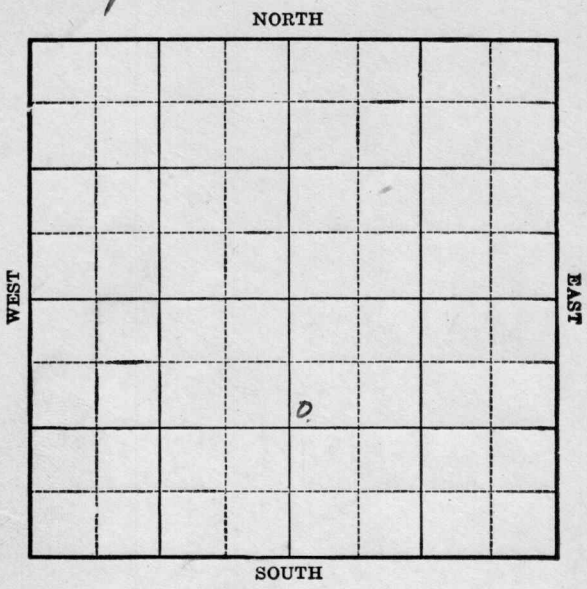

Location _____

Drilling Remarks:

Rig Up _____

Drilling Remarks:

RECORD

Cased _____ in. _____ ft.

Sand _____

Gas _____

Oil _____

Total Depth _____

PRODUCTION

1st 24 hrs. Nat. _____

1st 24 hrs. after shot _____

Gas _____ cu. ft.

Dry Hole _____

Abandoned _____

Greenwood

Form 252A 5M 8-24 16529

Map No. Kansas Sec. 17 Twp. 22 R 13

Well No. 1 W Engler Farm


Empire G. & F. Company

990 Ft. from N. Line

Ft. from S. Line

Ft. from E. Line

330 Ft. from W. Line

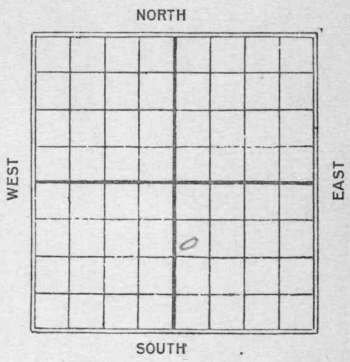

Date	REPORT
1925	
3/24	Rig up
5/29	Abandoned 2318

Form 26—1M Bks.—3-23—11959.

Greenwood

No Map KANSAS

Map No. _____ Sec. 17 Twp. 23 R. 13


Well No. 1 Winfield

Empire G. & F. Company

_____ Contractor

FIRST REPORT

SECTION PLAT

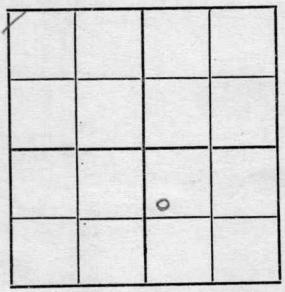

990 Ft. from N. Line

_____ Ft. from S. Line

_____ Ft. from E. Line

330 Ft. from W. Line

Location _____

Rig up _____

Drilling and Remarks:

RECORD

Cased _____ in., _____ ft.

Sand _____

Gas _____

Oil _____

Total Depth _____

PRODUCTION

1st 24 hrs. Nat. _____

1st 24 hrs. after shot _____

Gas _____ Cu. Ft.

Dry Hole _____

Abandoned _____

Date

3/24 1923

M. A. BENEAR Scout

Form 26—1M Bks.—3-23—11959.

Map No. Kans Sec. 17 Twp. 22 R. 13

Well No. 1 Winzler

Empire Gas & Fuel Co. Company

_____ Contractor

COMPLETED

990 Ft. from N. Line


_____ Ft. from S. Line

_____ Ft. from E. Line

330 Ft. from W. Line

ABANDONED

SECTION PLAT

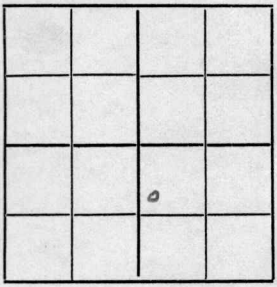

Location _____

Rig up _____

Drilling and Remarks:

Top lime 1830'

TD 2318'

Dry & abd

RECORD

Cased _____ in., _____ ft.

Sand _____

Gas _____

Oil _____

Total Depth 2318

PRODUCTION

1st 24 hrs. Nat. _____

1st 24 hrs. after shot _____

Gas _____ Cu. Ft.

Dry Hole ✓

Abandoned ✓

Date

MAY 29 1925

192____

CHAS. L. SHERWOOD

_____ Scout