


Map No. KANSAS Sec. 17 Twp. 22 R. 13
 Well No. 1-Miller Farm
W. H. Schwartz et al Company

NORTH

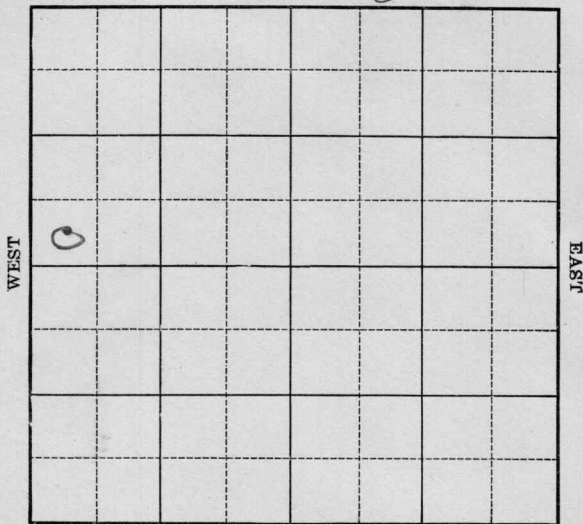

SOUTH

Location _____

Drilling Remarks _____

Rig Up _____

Drilling Remarks _____

RECORD

Cased _____ in. _____ ft.

Sand _____

Gas _____

Oil _____

Total Depth _____

PRODUCTION

1st 24 hrs. Nat. _____

1st 24 hrs. after shot _____


Gas _____ cu. ft.

Dry Hole _____

Abandoned _____

Map No. **KANSAS** Sec. **17** Twp. **22** R. **13**
 Well No. **1-5 Miller** Farm
H. H. Schwartz et al Company

NORTH

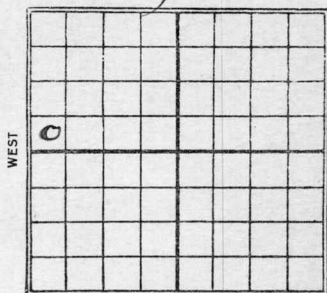

Ft. from N. Line

330 Ft. from S. Line

Ft. from E. Line

330 Ft. from W. Line

SOUTH

1928

Date

REPORT

Date	REPORT
5/10	Rig up
5/18	Drilg 700
5/24	Crooked hole 700
5/31	fighting crooked hole 700
6/7	Drilg 1000
6/14	Sand 1565-1600-H.F.W.
	Sdy shale 1615-30
	Sdy shale 1680-1700-
	Sand 1705-10-drilg 1780
6/20	sand 1565-1600-H.F.W.
	sdy shale 1615-1630
	" " 1680-1700
	sandy 1705-10
	Top line 1815'
	H.F.W. 1850'-H.F.W.

KANSAS

MAP NO. _____ SEC. 17 TWP. 22 R. 13WELL NO. 1 MillerW. A. Schwartz et al COMPANY

CONTRACTOR

SECTION PLAT

FIRST REPORTS

Ft. FROM N. LINE

330

Ft. FROM S. LINE

Ft. FROM E. LINE

330

Ft. FROM W. LINE

0			

RECORD

LOCATION _____

CASED _____ IN. _____ FT.

RIG UP _____

SAND _____

DRILLING AND REMARKS:

GAS _____

OIL _____

TOTAL DEPTH _____

PRODUCTION

1ST 24 HRS. NAT. _____

1ST 24 HRS. AFTER SHOT _____

GAS _____ CU. FT.

DRY HOLE _____

ABANDONED _____

DATE

MAY 10 1928

CHAS. L. SHERWOOD

192

SCOUT

S. M. Wood

MAP NO. KANSAS SEC. 17 TWP. 22 R. 13

WELL NO. 1 Miller

W. H. Schwartz COMPANY

CONTRACTOR

COMPLETED

SECTION PLAT

FT. FROM N. LINE

330

FT. FROM S. LINE

FT. FROM E. LINE

330

FT. FROM W. LINE

ABANDONED

LOCATION

RIG UP

DRILLING AND REMARKS:

Hard 1565-1600 NEW
Soy Shale 1615-30

1680-1700

Hard 1705-10

TL 1815

Drill 1850 NEW

RECORD

CASED IN. FT.

SAND

GAS

OIL

TOTAL DEPTH 1850

PRODUCTION

1ST 24 HRS. NAT.

1ST 24 HRS. AFTER SHOT

GAS CU. FT.

DRY HOLE ☒

ABANDONED ☒

DATE

JUN 20 1928

CHAS. L. SHERWOOD

SCOUT