


Map No. 10a Sec. 18 Twp. 22 R. 13

Well No. 1 Ott Farm

Empire G. & F. Company

NORTH

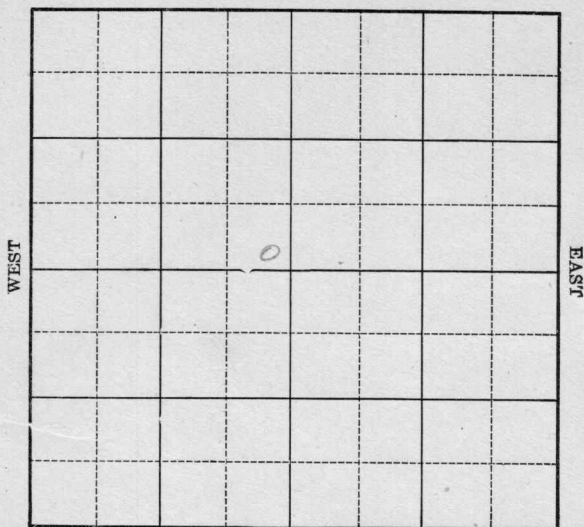

SOUTH

Location _____

Drilling Remarks

Rig Up_____

Drilling Remarks

RECORD

Cased_____in. _____ft.

Sand

Gas

Oil

Total Depth.....

PRODUCTION

1st 24 hrs. Nat. _____

1st 24 hrs. after shot -----

Gas_____cu. ft.

Dry Hole


Abandoned

Map No. _____ Sec. 18 Twp. 22 R. 13Well No. 1 Ott Farm _____
Empire G. & F. Company _____

_____ Ft. from N. Line

250' Ft. from S. Line250' Ft. from E. Line

_____ Ft. from W. Line

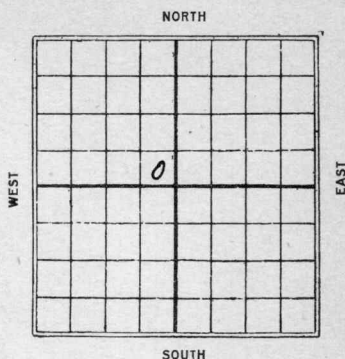1926

Date

REPORT

2/10	Timber
2/17	Bldg rig.
2/24	Rigging up.
3/5	Dlg 285
3/10	" 995
3/18	" 1670
3/25	" 1775
4/1	Top line 1775 Dlg 2130
4/7	Top Sand 2177-2197' 50' heavy oil in hole. Dreg 2197.
4/14	Top line 1775 Sd. 2177-2203. Shot 12% making 6 Bailers oil and 6 Bailers water per hour. cleaning out.
4/21	Sd. 2177-2203. - I.D. 2203. Top line 1775 12% 45 bbl. oil. 45 water.

Map No. *normal* **KANSAS** Sec. *18* Twp. *22* R. *13*

Well No. *1* *off*


Contractor _____

SECTION PLAT

_____ Ft. from N. Line

250 _____ Ft. from S. Line

250 _____ Ft. from E. Line

_____ Ft. from W. Line

FIRST REPORTS

Location *Lumber.* _____

Rig up _____

Drilling and Remarks:

RECORD

Cased _____ in., _____ ft.

Sand _____

Gas _____

Oil _____

Total Depth _____

PRODUCTION

1st 24 hrs. Nat. _____

1st 24 hrs. after shot _____

Gas _____ Cu. Ft.

Dry Hole _____

Abandoned _____

Date

FEB 10 1926

CHAS. L. SHERWOOD

192

Scout

Wm. Sherwood
 Map No. **KANSAS** Sec. *18* Twp. *22* R. *13*
 Well No. *1* *off*

Empire Oil & Gas Co. Company

Contractor

COMPLETED

_____ Ft. from N. Line

250 _____ Ft. from S. Line

250 _____ Ft. from E. Line

_____ Ft. from W. Line

SECTION PLAT

Location _____

Rig up _____

Drilling and Remarks:

Top run 1775

120' 45' B.S.O.D.
45' " Water

RECORD

Cased _____ in., _____ ft.

Sand *2177-* *2203*

Gas _____

Oil _____

Total Depth *2203*

PRODUCTION

1st 24 hrs. Nat. _____

1st 24 hrs. after shot _____

Gas _____ Cu. Ft.

Dry Hole _____

Abandoned _____

Date

APR 21 1926

CHAS. L. SHERWOOD

192

Scout