
Form 51 5M 7-22 9573

Map No. _____ Sec. 15 Twp. 23 R. 13

Well No. 3 Shadel Farm

Ralco Oil Company

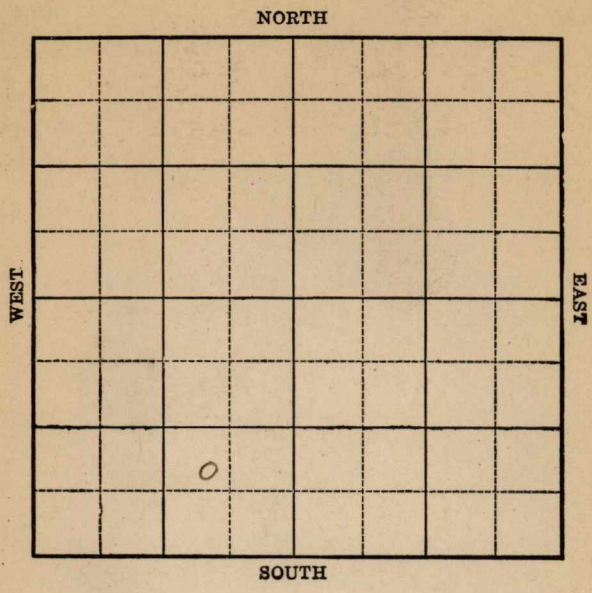

Location _____

Drilling Remarks:

Rig up _____

Drilling Remarks:

RECORD

Cased _____ in. _____ ft.

Sand _____

Gas _____

Oil _____

Total Depth _____

PRODUCTION

1st 24 hrs Nat. _____

1st 24 hrs. after shot _____

Gas _____ cu. ft.

Dry Hole _____

Abandoned _____

Form 252A 8M-11-20 PALACE-TULSA 4617

Map No. Sec. 15 Twp. 23 R. 13

Well No. 3 Shadel Farm

Ralco Oil Company


NORTH

760 Ft. from N. Line

760 Ft. from S. Line

760 Ft. from E. Line

Ft. from W. Line

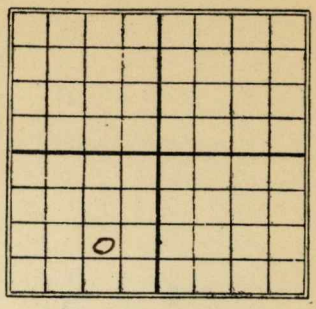

Date	REPORT
1923	
2/24	Rig.
3/30	Pay 1574-1626 - Shot 100 qts. 500 Bbls.

Form 26—1M—4-19—Mid-West

Map No. KANSAS Sec. 15 Twp. 23 R. 13


Well No. 3 Schadel

Ralco Company

Contractor

FIRST REPORT

SECTION PLAT

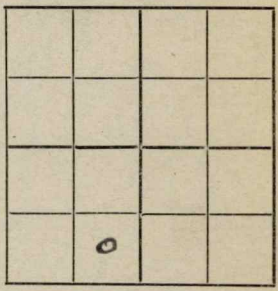

Ft. from N. Line

760 Ft. from S. Line

760 Ft. from E. Line

Ft. from W. Line

Location

Rig up

Drilling and Remarks:

RECORD

Cased in., ft.

Sand

Gas

Oil

Total Depth

PRODUCTION

1st 24 hrs. Nat.

1st 24 hrs. after shot

Gas Cu. Ft.

Dry Hole

Abandoned

Date

FEB 24 1923

191

M. A. BENEAR

Scout

Form 26—1M—4-19—Mid-West

Map No. KANSAS Sec. 15 Twp. 23 R. 13


Well No. 3 Shadel

Kaloo Company

Contractor

COMPLETED

SECTION PLAT

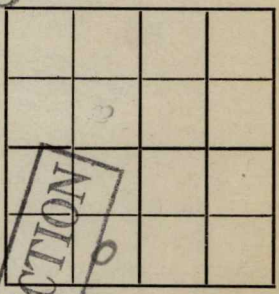

760 Ft. from N. Line

760 Ft. from S. Line

Ft. from E. Line

Ft. from W. Line

RETURNED FOR CORRECTION

Location

Rig up

Drilling and Remarks:

Pay 1574
1626
shot 40/500 ft

RECORD

Cased in., ft.

Sand

Gas

Oil

Total Depth

PRODUCTION

1st 24 hrs. Nat.

1st 24 hrs. after shot

Gas Cu. Ft.

Dry Hole

Abandoned

Date

MAR 30 1923

191

M. A. BENEAR

Scout

This was first reported in SW/4. Which is correct?



Returned	
Cards	
Tracing	
J. S. C. map	
Frantz map	
Moody map	
Frantz plat book	
Moody plat book	