

Section 22 Township 22 Range 13-E

Well No. #1 Ensley

Company Aikman & Braden
(Misc.)

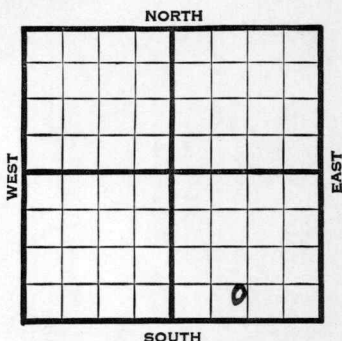
NORTH

15

WEST

EAST

SOUTH

Sec. 22 Twp. 22 R. 13-EWell No. #1 Ensley FarmAikman & Braden Company
(Miscellaneous) Ft. from N. Line500' Ft. from S. Line Ft. from E. Line1295' Ft. from W. Line

	REPORT
1941	
7/30	10" 669'
	Drlg. 765'
8/7	8" @ 1131' Drl g. 1170'
8/15	Burgess 1807-16
	Miss 1821-27 TD
	6" 1779
8/21	5" - 1821' C.O.
8/28	T.D. 1833' 1250 acid.
	Pump 10 oil.
9/4	Shot 60 qts. 1803-19' S.W.
9/10	Miss. 1821'
	6" - 1779'
	5" - 1821'
	T.D. 1833'
	1250 acid.
	Shot 60 qts. 1803-19'
	Pump 10 oil & 60 water.
	36. Gravity
	COMPLETED

Map No. 20 Sec. 22 Twp. 22 R. 13EWell No. 1 EnsleyAikman & Braden Company

Contractor

FIRST REPORT

NE SE SW SE

SECTION PLAT

Ft. from N. Line

500 Ft. from S. Line

Ft. from E. Line

1295 Ft. from W. Line**MISCELLANEOUS**

Location _____

Rig up _____

Drilling and Remarks:

10" - 669Drlg. 765**RECORD**

Cased _____ in., _____ ft.

Sand _____

Gas _____

Oil _____

Total Depth _____

PRODUCTION

1st 24 hrs. Nat. _____

1st 24 hrs. after shot _____

Gas _____ Cu. Ft.

Dry Hole _____

Abandoned _____

Date

JUL 30 1941 19S. J. LEWIS Scout

Map No. 20 Sec. 22 Twp. 22 R. 13EWell No. 1 EnsleyAikman & Braden CompanyCOMPLETED Contractor

SECTION PLAT

NE SE SW SE

 Ft. from N. Line500 Ft. from S. Line Ft. from E. Line1295 Ft. from W. Line

MISCELLANEOUS

Location Rig up

Drilling and Remarks:

*Miss 1821**6" @ 1779**5" @ 1821**1200 acw**609 to 1803-19.**Pump 10 oil 60 water**36 @ 1821*

RECORD

Cased in., ft.Sand Gas Oil Total Depth 1833

PRODUCTION

1st 24 hrs. Nat. 1st 24 hrs. after shot Gas Cu. Ft.Dry Hole Abandoned

Date

SEP 10 1941 19S. J. LEWIS Scout