


Section 22 Township 22 Range 13E

Well No. 1 Povenior *(Povenmire)*

Company Bill Braden

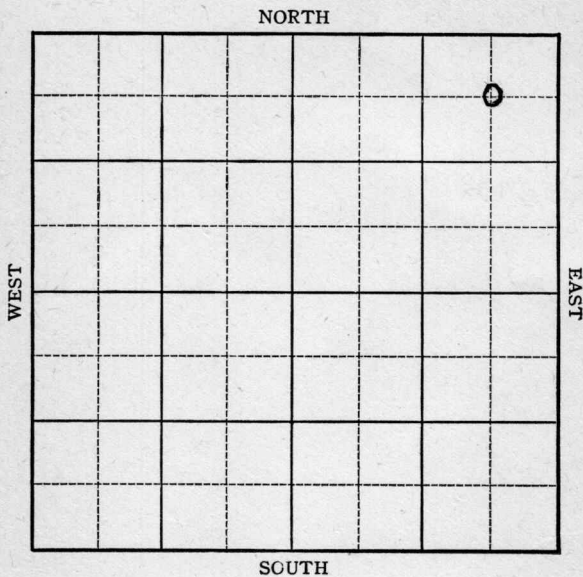

KANSAS

Greenwood County

Sec. 22 Twp. 22 R. 13E

Well No. #1 Povenior Farm

Bill Braden Company


Miscellaneous

660 Ft. from N. Line

 Ft. from S. Line

660 Ft. from E. Line

 Ft. from W. Line

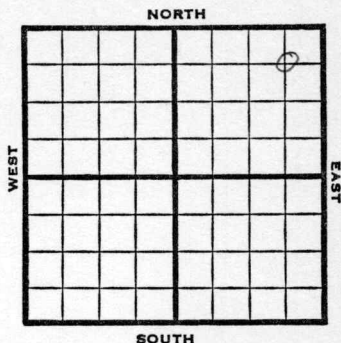

CWE NE

1946

REPORT

5/22 10" @ 700
8" @ 1147
1180'

5/29 Miss 1881'
6" @ 1830'
TD 1885'

ABANDONED

82
KANSASPool Name MiscellaneousMap No. _____ Sec. 22 Twp. 22 R. 13EWell No. 1 PoveniorBill Braden CompanyFIRST REPORT Contractor

C W E NE

SECTION PLAT

660 Ft. from N. Line

_____ Ft. from S. Line

660 Ft. from E. Line

_____ Ft. from W. Line

			o

Greenwood County

Location _____

Rig up _____

Drilling and Remarks:

10" @ 700

8" @ 1147

1180

RECORD

Cased _____ in., _____ ft.

Sand _____

Gas _____

Oil _____

Total Depth _____

PRODUCTION

1st 24 hrs. Nat. _____

1st 24 hrs. after shot _____

Gas _____ Cu. Ft.

Dry Hole _____

Abandoned _____

Date

MAY 22 1946 19 S. J. LEWIS Scout

KANSAS Kansas Pool Name Miscellaneous
 Map No. 821 Sec. 22 Twp. 22 R. 13E
 Well No. 1 Povenier

Bill Braden

Company

ABANDONED

Contractor

C NE NE

SECTION PLAT

660 Ft. from N. Line

 Ft. from S. Line

660 Ft. from E. Line

 Ft. from W. Line

Greenwood County

Location

Rig up

Drilling and Remarks:

Miss 1881
6" C 1830

RECORD

Cased in., ft.

Sand

Gas

Oil

Total Depth 1885

PRODUCTION

1st 24 hrs. Nat.

1st 24 hrs. after shot

Gas Cu. Ft.

Dry Hole

Abandoned

Date

MAY 29 1946 19

S. J. LEWIS

Scout