


Map No. **KANSAS** Sec. **22** Twp. **22** R. **13**
Well No. **2 - Povenmire** Farm
Braden & McClure Company

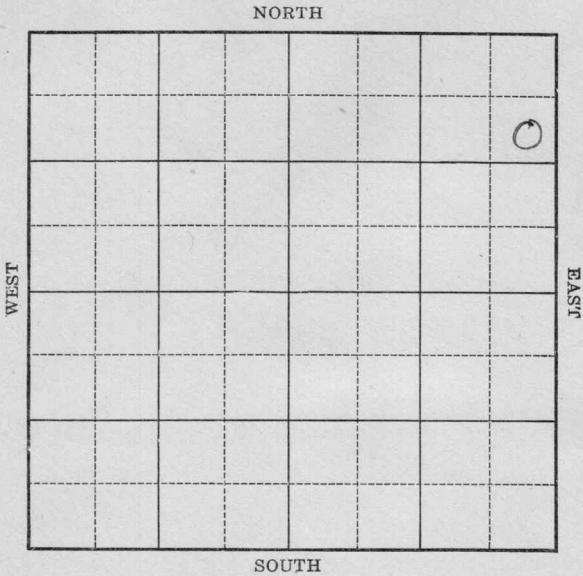

Location _____
Drilling Remarks _____

RECORD

Cased _____ in. _____ ft.
Sand _____
Gas _____
Oil _____
Total Depth _____

Rig Up _____
Drilling Remarks _____

PRODUCTION

1st 24 hrs. Nat. _____
1st 24 hrs. after shot _____
Gas _____ cu. ft.
Dry Hole _____
Abandoned _____


Map No. KANSAS Sec. 22 Twp. 22 R. 13Well No. 2 - Povannire Farm
Braden & McClure Company990 Ft. from N. Line

_____ Ft. from S. Line

330 Ft. from E. Line

_____ Ft. from W. Line

NORTH

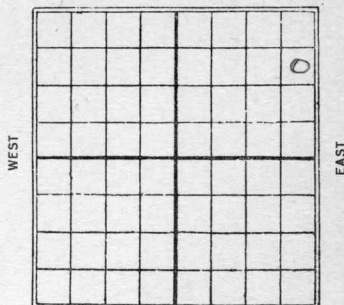

SOUTH

1928

Date

REPORT

Date	REPORT
4/12	Rigging up
4/19	Drill 350
4/26	" 840
5/3	" 1060
5/10	" 1720
5/17	1828-1861 T.D. 1861
	30 gts - 15 bbl oil

Map No. _____ Sec. 22 Twp. 22 R. 13

Well No. 2 Pocahontas

Broden & McClure Company

Contractor

FIRST REPORTS

SECTION PLAT

990 Ft. from N. Line

_____ Ft. from S. Line

330 Ft. from E. Line

_____ Ft. from W. Line

			0

Location _____

Rig up _____

Drilling and Remarks:

Rigging up

RECORD

Cased _____ in., _____ ft.

Sand _____

Gas _____

Oil _____

Total Depth _____

PRODUCTION

1st 24 hrs. Nat. _____

1st 24 hrs. after shot _____

Gas _____ Cu. Ft.

Dry Hole _____

Abandoned _____

Date

APR 12 1928

CHAS. L. SHERWOOD

_____ 192 _____ Scout

no drawing
KANSASMAP NO. _____ SEC. 22 TWP. 22 R. 13WELL NO. 2 GovernmentBradley & Mc Clure COMPANY

CONTRACTOR

COMPLETED

SECTION PLAT

			0

990

FT. FROM N. LINE

FT. FROM S. LINE

330

FT. FROM E. LINE

FT. FROM W. LINE

RECORD

LOCATION _____

CASED _____ IN. _____ FT.

RIG UP _____

SAND 1828-1861

DRILLING AND REMARKS:

GAS _____

OIL _____

TOTAL DEPTH 1861

PRODUCTION

1ST 24 HRS. NAT. _____

1ST 24 HRS. AFTER SHOT _____

GAS _____ CU. FT.

DRY HOLE _____

ABANDONED _____

DATE

MAY 17 1928

CHAS. L. SHERWOOD

192

SCOUT