

Map No. KANSAS Sec. 22 Twp. 22 R. 13^E

Well No. 3- Pavemir Farm
Braden et al Company

NORTH

WEST

EAST

SOUTH

Location _____

Drilling Remarks

Rig Up _____

Drilling Remarks

RECORD

Cased _____ in. _____ ft.

Sand _____

Gas _____

Oil _____

Total Depth _____

PRODUCTION

1st 24 hrs. Nat. _____

1st 24 hrs. after shot _____

Gas _____ cu. ft.

Dry Hole _____

Abandoned _____


Map No. KANSAS Sec. 22 Twp. 22 R. 13^E
Well No. 3 - Pavemier Farm
Braden et al Company

1120 Ft. from N. Line

 Ft. from S. Line

660 Ft. from E. Line

 Ft. from W. Line

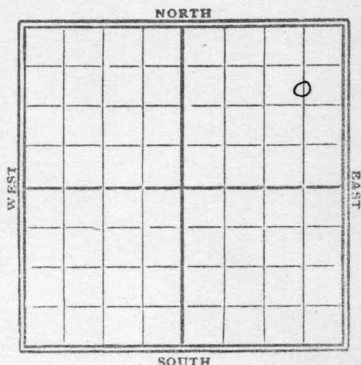

1929

Date

REPORT

9/11 Top line 1840'
sand 1845-61'
T.D. 1861'
shot 80 gts
15 bbl oil
Pump.

20 KANSAS

Map No. _____ Sec. 22 Twp. 22 R. 13^EWell No. 3Lawrence
Bradley & Co

Company

Contractor

FIRST REPORTS
COMPLETE1120 Ft. from N. Line

_____ Ft. from S. Line

660 Ft. from E. Line

_____ Ft. from W. Line

SECTION PLAT

			o

Location _____

Rig up _____

Drilling and Remarks:

Top line 1840'
Sand 1845-61'80/15 Bls.

RECORD

Cased _____ in., _____ ft.

Sand _____

Gas _____

Oil _____

Total Depth 1861'

PRODUCTION

1st 24 hrs. Nat. _____

1st 24 hrs. after shot _____

Gas _____ Cu. Ft.

Dry Hole _____

Abandoned _____

Date

SEP 11 1929

CHAS. L. SHERWOOD

19

Scout