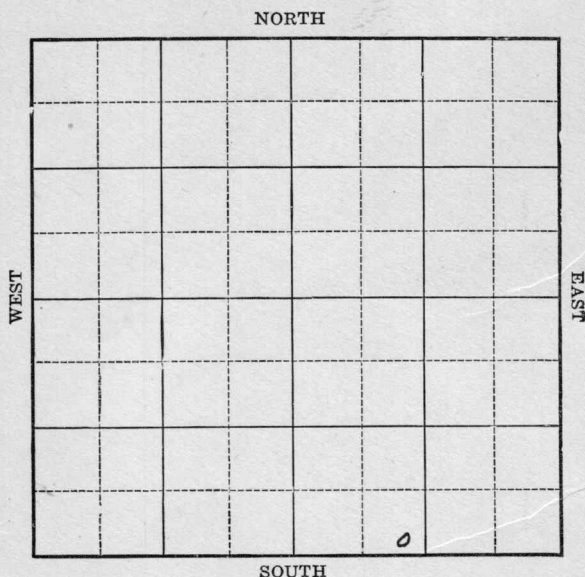


Map No. Kansas Sec. 22 Twp. 22 R. 13
 Well No. 1 Weidie (Weider) Farm
R. G. Gillespie ? Company



Location _____
 Drilling Remarks _____

Rig Up _____
 Drilling Remarks _____

RECORD

Cased _____ in. _____ ft.
 Sand _____
 Gas _____
 Oil _____
 Total Depth _____

PRODUCTION

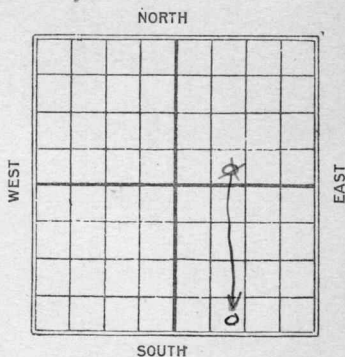
1st 24 hrs. Nat. _____
 1st. 24 hrs. after shot _____
 Gas _____ cu. ft.
 Dry Hole _____
 Abandoned _____

Map No. *Kansas* Sec. *22* Twp. *22* R *13*Well No. *1 Weider* Farm*R. G. Gillespie* Company

Ft. from N. Line

200 Ft. from S. Line

Ft. from E. Line

1120 Ft. from W. Line

C.

Date

REPORT

*1925**3/24**Rig up**8/14 980' Lost hole**Aband*

Map No. **KANSAS** Sec. 22 Twp. 22 R. 13Well No. 1 WeiderR. G. Gillespie Company

Contractor

FIRST REPORT

SECTION PLAT

Ft. from N. Line

200 Ft. from S. Line

Ft. from E. Line

1120 Ft. from W. Line

		0	

Location

Rig up ✓✓

Drilling and Remarks:

RECORD

Cased _____ in., _____ ft.

Sand _____

Gas _____

Oil _____

Total Depth _____

PRODUCTION

1st 24 hrs. Nat. _____

1st 24 hrs. after shot _____

Gas _____ Cu. Ft.

Dry Hole _____

Abandoned _____

Date

3/24 1925

M. A. BENEAR

Scout

Map No. *22* Sec. *22* Twp. *22* R. *12*Well No. *1* *Wade**R. B. Bells pie* Company

Contractor

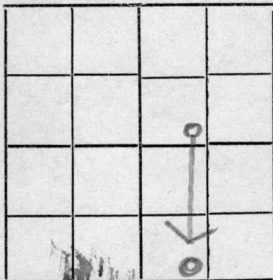
CORRECTION

SECTION PLAT

Ft. from N. Line

300 Ft. from S. Line

Ft. from E. Line

1120 Ft. from W. Line*1st Report*

Location -----

Rig up -----

Drilling and Remarks:

SL 980'
litigation

CORRECTION

chg location.

RECORD

Cased ----- in., ----- ft.

Sand -----

Gas -----

Oil -----

Total Depth -----

PRODUCTION

1st 24 hrs. Nat. -----

1st 24 hrs. after shot -----

Gas ----- Cu. Ft.

Dry Hole -----

Abandoned -----

Date

APR 17 1925

192

Chs. L. Sherwood
Scout

Map No. 15nd Sec. 22 Twp. 22 R. 13Well No. 1 HeidiR. B. Pillspie Company

Contractor

COMPLETED

SECTION PLAT

Ft. from N. Line

300 Ft. from S. Line

Ft. from E. Line

1120 Ft. from W. Line

ABANDONED

Location

Rig up

Drilling and Remarks:

abandoned at
980' Lost lease

RECORD

Cased _____ in., _____ ft.

Sand _____

Gas _____

Oil _____

Total Depth 980'

PRODUCTION

1st 24 hrs. Nat. _____

1st 24 hrs. after shot _____

Gas _____ Cu. Ft.

Dry Hole _____

Abandoned ☒

Date

MAY 21 1925

192

CHAS. L. SHERWOOD

Scout

Map No. KANSAS Sec. 22 Twp. 22 R. 13

Well No. 1 Weldie

B. B. Bullespie Company

Contractor

COMPLETED

Ft. from N. Line

200 Ft. from S. Line

Ft. from E. Line

1120 Ft. from W. Line

ABANDONED

SECTION PLAT

Location

Rig up

Drilling and Remarks:

up 980' lost
lease.

RECORD

Cased _____ in., _____ ft.

Sand _____

Gas _____

Oil _____

Total Depth 980'

PRODUCTION

1st 24 hrs. Nat. _____

1st 24 hrs. after shot _____

Gas _____ Cu. Ft.

Dry Hole _____

Abandoned ☒

Date

AUG 14 1925

CHAS. L. SHERWOOD

192

Scout