


Map No. KANSAS Sec. 22 Twp. 22 R. 13

Well No. 3 Young Farm
Arkman & Verhey Company

NORTH

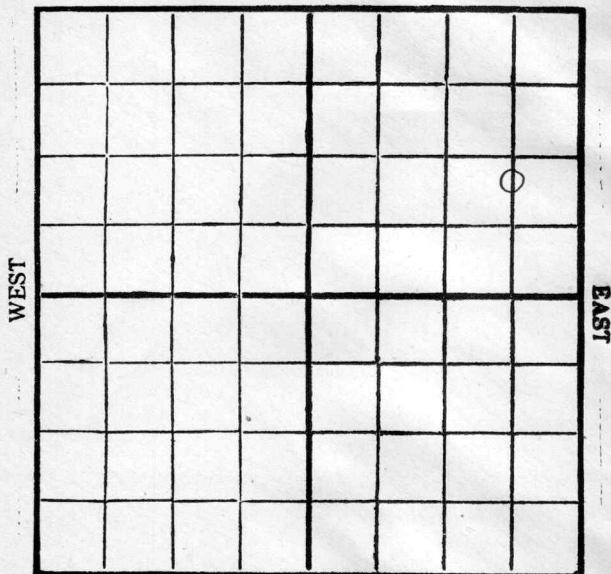

SOUTH

Location _____

Drilling Remarks

Rig Up _____

Drilling Remarks

RECORD

Cased _____ in. _____ ft.

Sand _____

Gas _____

Oil _____

Total Depth_____

PRODUCTION

1st 24 hrs. Nat. _____

1st 24 hrs. after shot_____

Gas_____cu. ft._____

Dry Hole_____

Abandoned _____

Map No. KANSAS Sec. 22 Twp. 22 R. 13^E


Well No. 3- Young Farm
Aikman & Herby Company

 Ft. from N. Line

1120 Ft. from S. Line

660 Ft. from E. Line

 Ft. from W. Line

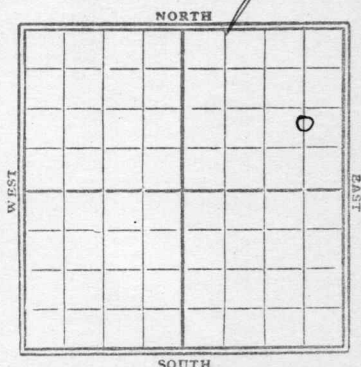

1929

Date

REPORT

Location

Machine

Wrlg 435'

12" 503'

Wrlg 970'

" 1440'

Sand 1805-10'

2 bails oil per hr

UIR 6" there

Sand 1805-20'

Top line 1820'

Pay 1805-20'

T.D. 1840'

Making 100 bbl oil

and 10 " water

Pump.

Greenwood

20 KANSAS

Map No. _____ Sec. 22 Twp. 22 R. 13^E

Well No. 3 Young

Aikman & Derby Company

Contractor

FIRST REPORTS

_____ Ft. from N. Line

1120 Ft. from S. Line

660 Ft. from E. Line

_____ Ft. from W. Line

SECTION PLAT

			0

Location ✓ _____

Rig up _____

Drilling and Remarks:

RECORD

Cased _____ in., _____ ft.

Sand _____

Gas _____

Oil _____

Total Depth _____

PRODUCTION

1st 24 hrs. Nat. _____

1st 24 hrs. after shot _____

Gas _____ Cu. Ft.

Dry Hole _____

Abandoned _____

Date

SEP 18 1929

192

CHAS. L. SHERWOOD

Scout

Greenwood

20

Map No. KANSAS Sec. 22 Twp. 22 R. 13

Well No. 3 Young

Aixman & Derby Company

Contractor

COMPLETE

SECTION PLAT

			0

Ft. from N. Line

1170 Ft. from S. Line

660 Ft. from E. Line

Ft. from W. Line

~~ABANDONED~~

Location

Rig up

Drilling and Remarks:

Top line 1870'
Pay 1805-1870'100 Bbls Oil
10 " Water.

RECORD

Cased in., ft.

Sand 1805-1870

Gas

Oil

Total Depth 1870

PRODUCTION

1st 24 hrs. Nat.

1st 24 hrs. after shot

Gas Cu. Ft.

Dry Hole

Abandoned

Date

CHAS. L. SHERWOOD

DEC 11 1929

192

Scout