


Map No. KANSAS Sec. 22 Twp. 22 R. 13

Well No. 4 - Young Farm
Broden & Bercht Company

NORTH

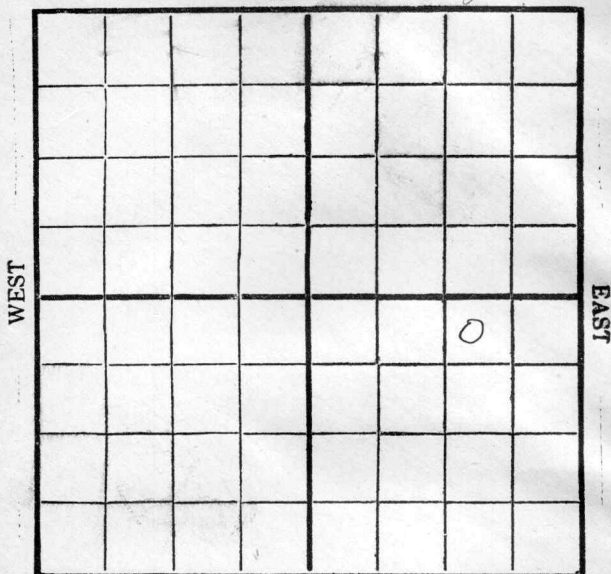

SOUTH

Location _____

Drilling Remarks

Rig Up _____

Drilling Remarks

RECORD

Cased _____ in. _____ ft.

Sand _____

Gas _____

Oil _____

Total Depth_____

PRODUCTION

1st 24 hrs. Nat. _____

1st 24 hrs. after shot_____

Gas _____ cu. ft. _____

Dry Hole_____

Abandoned _____

Map No. KANSAS Sec. 22 Twp. 22 R. 13^E

Well No. 4 - Young Farm
Braden & Herley Company

NORTH


250 Ft. from N. Line

_____ Ft. from S. Line

1070 Ft. from E. Line

1930 Ft. from W. Line

WEST

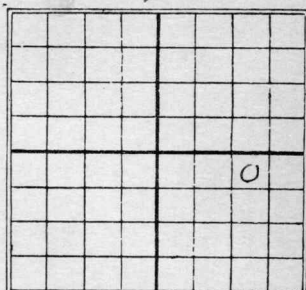

SOUTH

Date

REPORT

2/19 Drily 1200'
2/26 Burgess 1802-23
Top line 1823
T.D. 1832'
shot 60 qt 1802-23
Est 50 bbl oil
3/5 Top line 1823'
Sand 1802-23
Oil 1802-32'
T.D. 1832'
shot 60 qt
175 bbl oil
Comp.

Greenwood

KANSAS Map No. _____ Sec. *22* Twp. *22* R. *13*^E

Well No. *4 Young*

Braden & Derby Company _____

Contractor _____

FIRST REPORTS

SECTION PLAT

750 Ft. from N. Line

_____ Ft. from S. Line

1070 Ft. from E. Line

_____ Ft. from W. Line

			o

Location _____

Rig up _____

Drilling and Remarks: _____

By 1200'

RECORD

Cased _____ in., _____ ft.

Sand _____

Gas _____

Oil _____

Total Depth _____

PRODUCTION

1st 24 hrs. Nat. _____

1st 24 hrs. after shot _____

Gas _____ Cu. Ft.

Dry Hole _____

Abandoned _____

Date

FEB 19 1930

CHAS. L. SHERWOOD

192 _____ Scout

20 KANSAS

Map No. Sec. 22 Twp. 22 R. 13

Well No. 4 young

Braden & Derby Company

Contractor

COMPLETE

250 Ft. from N. Line

Ft. from S. Line

1070 Ft. from E. Line

Ft. from W. Line

SECTION PLAT

			o

Location

Rig up

Drilling and Remarks:

top line 1823'

60/175 Bls.

RECORD

Cased in, ft.

Sand 1802-1823

Gas

Oil 1802-1832

Total Depth 1832

PRODUCTION

1st 24 hrs. Nat.

1st 24 hrs. after shot

Gas Cu. Ft.

Dry Hole

Abandoned

Date

MAR 5 1930

CHAS. L. SHERWOOD

192

Scout