
KANSAS Greenwood

FORM 51 5M 4-41 PETROL

Section 22 Township 22 Range 13E

Well No. 8-Young

Company Aikman et al

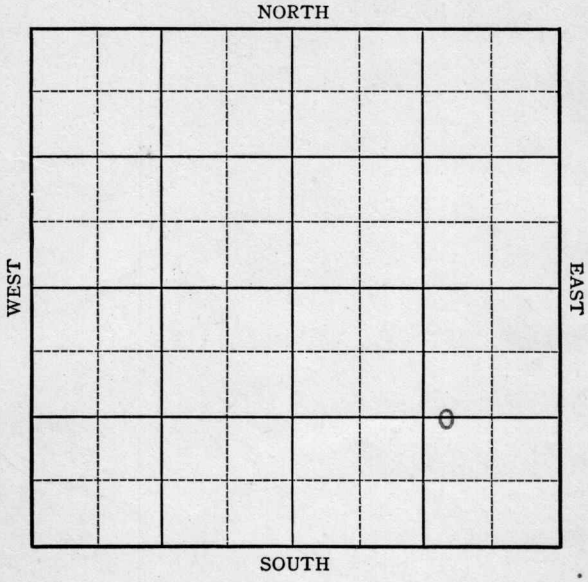

9

FORM 252-A 5M 6-41 PETROL KANSAS Greenwood

Sec. 22 Twp. 22 R. 13-E

Well No. #8 Young Farm

Aikman et al Company


(Misc.)

_____ Ft. from N. Line

1350 Ft. from S. Line

1020 Ft. from E. Line

_____ Ft. from W. Line

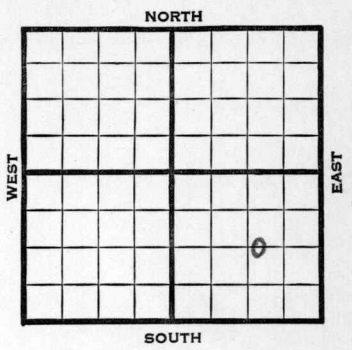

1941	REPORT
9/10	Machine.
9/18	"
9/25	10" - 674' Drlg. 765'
10/2	8" - 1135' Drlg. 1180'
10/9	Burgess 1807' Miss. 1817-27' TD
	30' oil 4 hours.
10/16	Shot 60 qts. 1807-27'
	T.D. 1833' Pump 18 oil 24 hours
10/22	Miss. 1817'
	5" - 1777'
	T.D. 1833'
	Potential 20 bbls., pump.
	33. Gravity
	COMPLETED

Form 26 200 Bks. 5-41 McW. Greenwood KANSAS

Map No. 20 Sec. 22 Twp. 22 R. 13E

Well No. 8 Young

Aikman etal Company

Contractor

FIRST REPORT

C WL E½ SE


Ft. from N. Line

1350 Ft. from S. Line

1020 Ft. from E. Line

Ft. from W. Line

SECTION PLAT

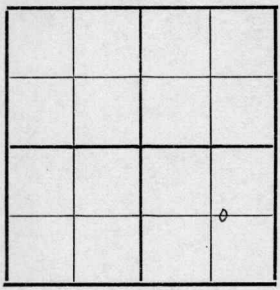

MISCELLANEOUS

Location

Rig up

Drilling and Remarks:

Machine

RECORD

Cased in., ft.

Sand

Gas

Oil

Total Depth

PRODUCTION

1st 24 hrs. Nat.

1st 24 hrs. after shot

Gas Cu. Ft.

Dry Hole

Abandoned

Date

SEP 10 1941 19

S. J. LEWIS Scout

Form 26 200 Bks. 5-41 McW. Greenwood KANSAS

Map No. K-20 Sec. 22 Twp. 22 R. 13E

Well No. 8 Young

Aikman etal Company

COMPLETED Contractor

C WL E½ SE

Ft. from N. Line


1350 Ft. from S. Line

1020 Ft. from E. Line

Ft. from W. Line

MISCELLANEOUS

SECTION PLAT

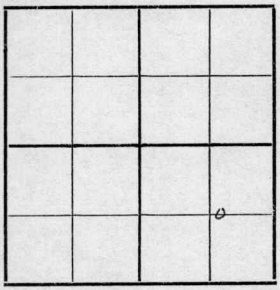

Location

Rig up

Drilling and Remarks:

Shis 1817
5"@ 1777
Pump 20 BO

33° Gr

RECORD

Cased in., ft.

Sand

Gas

Oil

Total Depth 1533

PRODUCTION

1st 24 hrs. Nat.

1st 24 hrs. after shot

Gas Cu. Ft.

Dry Hole

Abandoned

Date

OCT 22 1941 19

S. J. LEWIS Scout