
FORM 51 25M 8-50 WESTERN

Butler KANSAS

Section 4 Township 26 Range 4E.

Well No. #2 Rice

Company R. J. Wixson

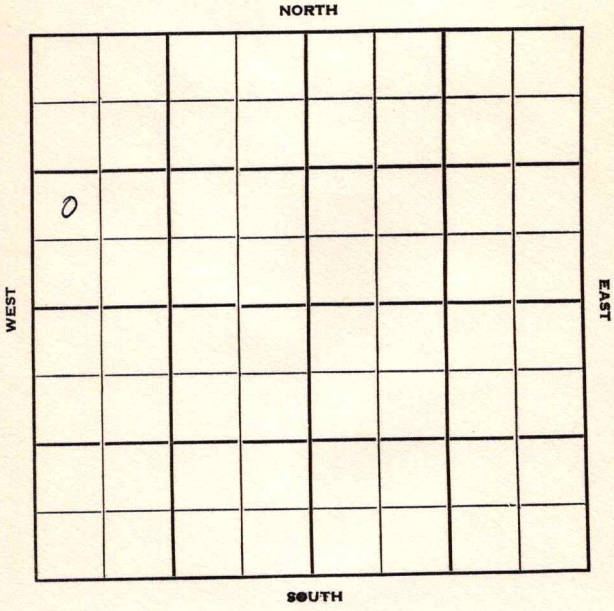

FORM 252-B
10M 11-50 PETROL

Butler

Sec. 4 Twp. 26 R. 4 E

Well No. # 2 Rice Farm

R. J. Wixson Company

Wixson Contractor

Towanda Pool


_____ Ft. from N. Line

990 Ft. from S. Line

_____ Ft. from E. Line

330 Ft. from W. Line

NW SW NW

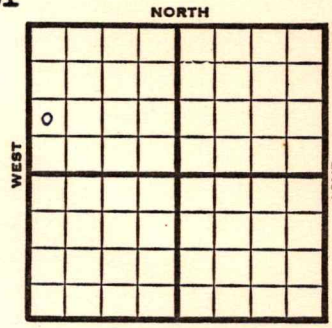

1951	Elev. 1305' REPORT
6/6	R U R
7/25	Spud 6-6-51 15" @ 150 KC 2055 Miss 2437 Viola 2624 7" @ 2624-27 Hydrafrac Comp. 22 bopd COMPLETED

FORM 275 FOR SALE BY KANSAS BLUE PRINT CO.

County Butler State Kansas

Sec. 4 (Blk. Twp.) 26 (Sur. Rge.) 4E Map No.

Operator R. J. Wixson

Well No. 2 Farm Rice

Elev. Location NW SW NW



990 Ft. From S Line NW

330 Ft. From W Line Quarter

1st. Report JUN 6 1951

Completion

Remarks Wixson - Contr.

Spudding Date

Drlg. Data Towanda Pool

R U R

J. E. TYRA

FORM 275 FOR SALE BY KANSAS BLUE PRINT CO.


County Butler State Kansas

Sec. 4 (Blk. Twp.) 26 (Sur. Rge.) 4E Map No.

Operator R. J. Wixson

Well No. 2 Farm Rice

Elev. 1305 Location NW SW NW

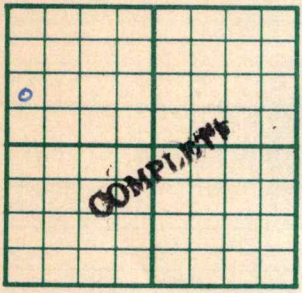

990 Ft. From S Line NW

330 Ft. From W Line Quarter

1st. Report

Completion JUL 25 1951

Remarks Towanda Pool

Wixson - Contr.

Spudding Date 6-6-51

Drlg. Data

15" @ 150 KC 2055 Miss. 2437

Viola 2624 7" @ 2624-27 Hydrofrac

Comp. 22 bopd

J. E. TYRA