
FORM 51 25M 8-50 WESTERN

Coffey KANSAS

Section 23 Township 22 Range 13E

Well No. #2 Swibold

Company Chris Thompson et al

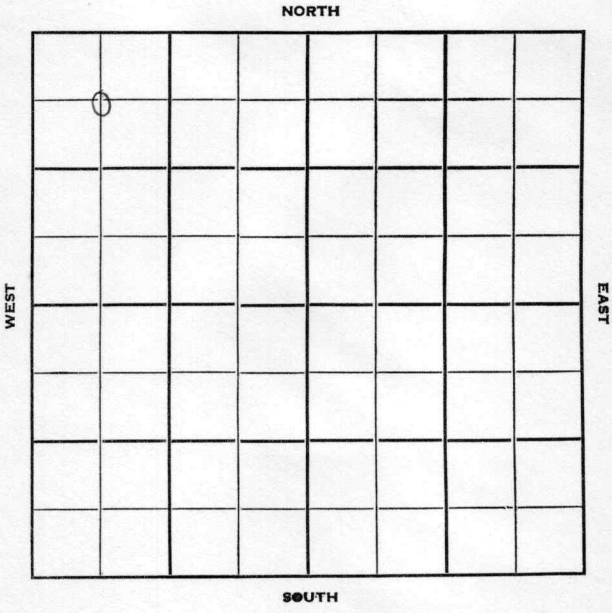

FORM 252-B
10M 10-50 PETROL

Coffey

KANSAS

Sec. 23 Twp. 22 R. 13E

Well No. #2 Swibold Farm

Chris Thompson et al Company

White & Ellis - Contr. Contractor


660' Ft. from N. Line

Ft. from S. Line

Ft. from E. Line

660' Ft. from W. Line

C NW NW

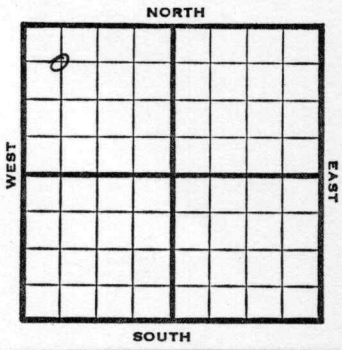

1950	REPORT
	Elv. -
11/29	Miss 1820' Drlg. 1823'
12/6	D&A TD 1866 Miss 1820 TD 1866 D&A ABANDONED

FORM 275 FOR SALE BY KANSAS BLUE PRINT CO.


County Coffey State Kansas

Sec. 23 (Blk. Twp.) 22 (Sur. Rge.) 13E Map No.

Operator Chris Thompson etal.

Well No. 2 Farm Swibold

Elev. Location C NW NW

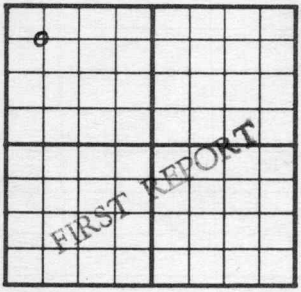

660 Ft. From N Line NW

660 Ft. From W Line Quarter

1st. Report NOV 29 1950

Completion

Remarks White & Ellis - Contr.

Spudding Date

Drlg. Data

Miss. 1820 drlg. 1823

J. E. TYRA

FORM 275 FOR SALE BY KANSAS BLUE PRINT CO.

County Coffey State Kansas

Sec. 23 (Blk. Twp.) 22 (Sur. Rge.) 13E Map No.

Operator Chris Thompson etal.

Well No. 2 Farm Swibold

Elev. Location C NW NW



660 Ft. From N Line NW

660 Ft. From W Line Quarter

1st. Report

Completion DEC 6 1950

Remarks

White & Ellis - Contr.

Spudding Date

Drlg. Data D & A TD 1866

Miss. 1820 TD 1866

D & A

J. E. TYRA