


Map No. _____ Sec. 26 Twp. 22 R. 13E

Well No. 1 Isch Farm _____
Altman & Braden Company

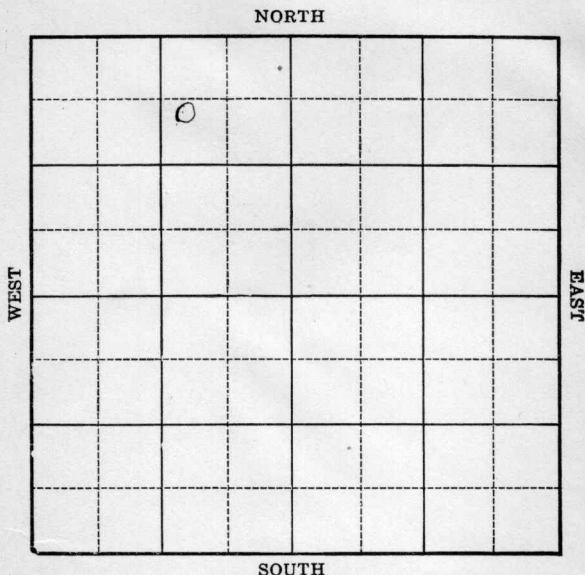

Location _____

Drilling Remarks _____

RECORD

Cased _____ in. _____ ft.

Sand _____

Gas _____

Oil _____

Total Depth _____

Rig Up _____

Drilling Remarks _____

PRODUCTION

1st 24 hrs. Nat. _____

1st 24 hrs. after shot _____

Gas _____ cu. ft.

Dry Hole _____

Abandoned _____

Coffey

Map No. KANSAS Sec. 26 Twp 22 R. 13 E

Well No. 1 *Isch* Farm


Aikman & Borden Company

680 Ft. from N. Line

_____ Ft. from S. Line

1050 Ft. from E. Line

_____ Ft. from W. Line

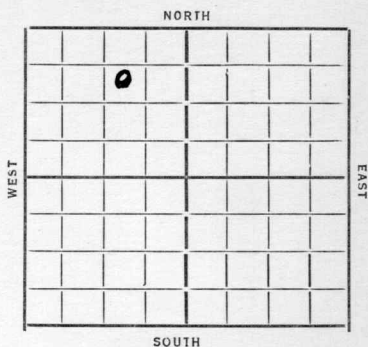

Date 1924

REPORT

7/25 TL 1845 TD 1887 D & A

FIRST REPORTS

✓

ABANDONED

Map No. 20 Sec. 26 Twp. 27 R. 13E

Well No. 1-22ch

Cikman & Braden Company

FIRST REPORTS

Contractor

ABANDONED

SECTION PLAT

	o		

680 Ft. from N. Line

_____ Ft. from S. Line

1050 Ft. from E. Line

_____ Ft. from W. Line

FIRST REPORTS

ABANDONED

Location _____

Rig up _____

Drilling and Remarks:

TL 1845

10 + H

RECORD

Cased _____ in., _____ ft.

Sand _____

Gas _____

Oil _____

Total Depth 1887

PRODUCTION

1st 24 hrs. Nat. _____

1st 24 hrs. after shot _____

Gas _____ Cu. Ft.

Dry Hole _____

Abandoned _____

Date

7-25-34 19

ORVAL MANNSCHRECK Scout