FORM 51 10M 8-47


Kansas

Butler County

Section 5 Township 26 Range 4E

Well No. 1 Edmiston

Company Rex Morris etal

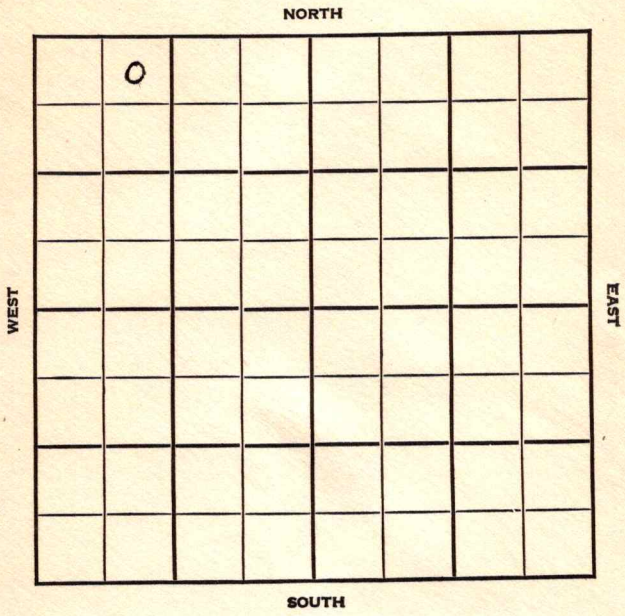

FORM 252-A
5M 9-47 PETROL

KANSAS

Butler

Sec. 5 Twp. 26 R. 4-E

Well No. #1 Edmiston Farm

Rex Morris et al Company

Miscellaneous


330' Ft. from N. Line

Ft. from S. Line

Ft. from E. Line

990' Ft. from W. Line

NE NW NW

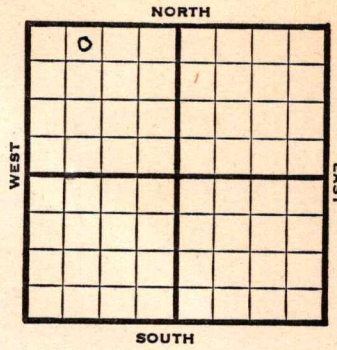

1947	REPORT
	Elev. 1267'
12/10	Machine
12/17	Spud.
12/30	15" @ 150' 13" @ 880' Drlg. 1325'
1948 1/7	10" @ 1650' Drlg. 1900'
1/14	10"@ 1725' Lansing 1 800' KC 2090' 8"@ 2190 ' Miss 2478' 6"@ 2478' 5"@ 2525'
1/21	Drlg. 2560' SD
1/28	Miss. 2540' Viola 2705' TD 2710' Abd.

ABANDONED

Form 26 200 Bks. 10-46 Petrol

Kansas

Miscellaneous

Map No. _____ Sec. 5 Twp. 26 R. 4E

Well No. 1 Edmiston

Rex Morris etal. Company

FIRST REPORT Contractor

NE NW NW


330 Ft. from N. Line

_____ Ft. from S. Line

_____ Ft. from E. Line

990 Ft. from W. Line

SECTION PLAT

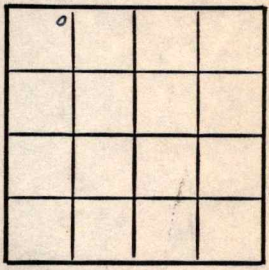

Butler County

Location _____

Rig up _____

Drilling and Remarks:

Machine

RECORD

Cased _____ in., _____ ft.

Sand _____

Gas _____

Oil _____

Total Depth _____

PRODUCTION

1st 24 hrs. Nat. _____

1st 24 hrs. after shot _____

Gas _____ Cu. Ft.

Dry Hole _____

Abandoned _____

Date

DEC 1 0 1947 19

S. J. LEWIS Scout

Form 26 200 Bks. 10-46 Petrol

Miscellaneous

Kansas

Map No. 14 Sec. 5 Twp. 26 R. 4E

Well No. 1 Edmiston


Rex Morris etal. Company

ABANDONED Contractor

NE NW NW

E 1,1267

SECTION PLAT

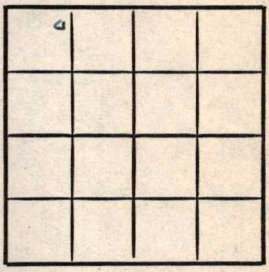

330 Ft. from N. Line

Ft. from S. Line

Ft. from E. Line

990 Ft. from W. Line

Butler County

Location

Rig up

Drilling and Remarks:

Miss 2540

Viola 2705

RECORD

Cased in., ft.

Sand

Gas

Oil

Total Depth 2710

PRODUCTION

1st 24 hrs. Nat.

1st 24 hrs. after shot

Gas Cu. Ft.

Dry Hole

Abandoned

Date

JAN 28 1948 19

S. J. LEWIS Scout