
Form 51-10M-7-20-CroMac Kansas

Map No. ____ Sec. 15 Twp. 23 R. 13

Well No. 3 Olinger Farm

Atlantic Company

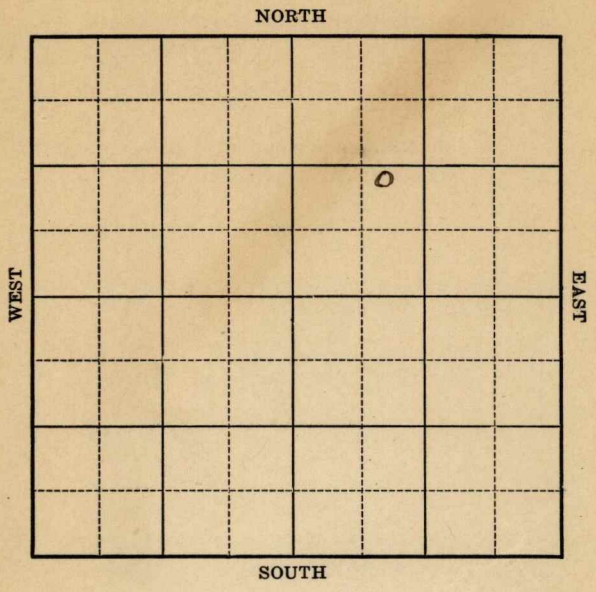

Location _____

Drilling Remarks:

Rig Up _____

Drilling Remarks:

RECORD

Cased _____ in. _____ ft.

Sand _____

Gas _____

Oil _____

Total Depth _____

PRODUCTION

1st 24 hrs. Nat. _____

1st 24 hrs. after shot _____

Gas _____ cu. ft.

Dry Hole _____

Abandoned _____

Form 252A 5M 8-21 PALACE—TULSA 6835

Map No. _____ Sec. 15 Twp. 23 R. 13

Well No. #3 Olinger Farm


Atlantic Company

_____ Ft. from N, Line

1120 Ft. from S. Line

_____ Ft. from E. Line

760 Ft. from W. Line

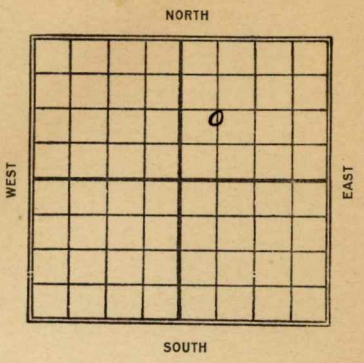

Date 1922	REPORT
7/15	Rig.
7/29	Td 1757-95
	Shot 60 qts 100 bbls

Form 26—1M—4-19—Mid-West

Map No. Kas 17 Sec. 15 Twp. 23 R. 13


Well No. 3 Olinger

Atlantic Company

Contractor

FIRST REPORT

SECTION PLAT

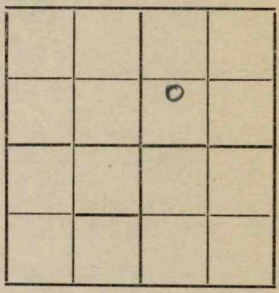

1120 Ft. from N. Line

Ft. from S. Line

Ft. from E. Line

760 Ft. from W. Line

Location

Rig up

Drilling and Remarks:

Rig.

RECORD

Cased in., ft.

Sand

Gas

Oil

Total Depth

PRODUCTION

1st 24 hrs. Nat.

1st 24 hrs. after shot

Gas Cu. Ft.

Dry Hole

Abandoned

Date

JUL 15 1922

191

M. A. BENEAR Scout

Form 26—1M—4-19—Mid-West

Map No. K17 Sec. 15 Twp. 23 R. 13


Well No. 3 Olinger

Atlantic Ref. Company

Contractor

COMPLETED

SECTION PLAT

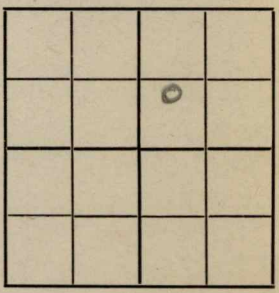

_____Ft. from N. Line

1120 Ft. from S. Line

_____Ft. from E. Line

760 Ft. from W. Line

Location _____

Rig up _____

Drilling and Remarks:

shot 60 qts.

RECORD

Cased _____ in., _____ ft.

Sand 1757-93

Gas _____

Oil _____

Total Depth _____

PRODUCTION

1st 24 hrs. Nat. _____

1st 24 hrs. after shot 100

Gas _____ Cu. Ft.

Dry Hole _____

Abandoned _____

Date

JUL 29 1922

_____ 191____

M. A. BENEAR

_____ Scout