


Map No. 15 Sec. 26 Twp. 22 R. 13
 Well No. 1 Kansas City Hay Farm
Perless Company

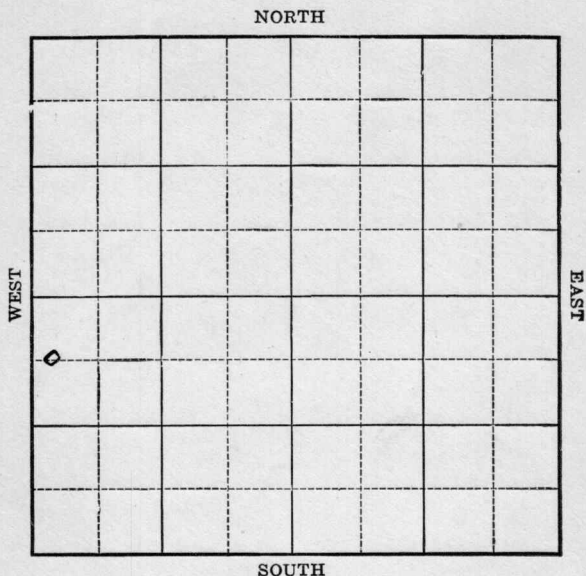

Location _____

Drilling Remarks:

RECORD

Cased _____ in. _____ ft.
 Sand _____
 Gas _____
 Oil _____
 Total Depth _____

Rig Up _____

Drilling Remarks:

PRODUCTION

1st 24 hrs. Nat. _____
 1st 24 hrs. after shot _____
 Gas _____ cu. ft.
 Dry Hole _____
 Abandoned _____

Map No. 11 Sec. 26 Twp. 22 R. 13


Well No. 1 Hansen Cnty Hay Farm
Pearless Company

660 Ft. from N. Line

_____ Ft. from S. Line

_____ Ft. from E. Line

700 Ft. from W. Line

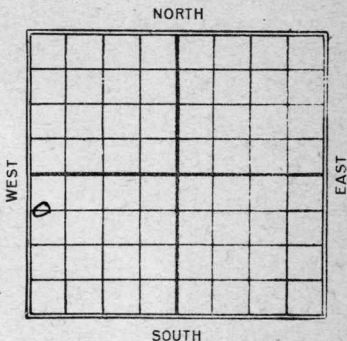

Date 1921

REPORT

8/6 Tap Line. 1855
10304 - 1904

No May **KANSAS** Map No. _____ Sec. *26* Twp. *22* R. *13*

Well No. *1* *Kans. City May Farm*

Reeless Company

Contractor

FIRST REPORT

SECTION PLAT

660' Completion
Ft. from N. Line

Ft. from S. Line

Ft. from E. Line

200'
Ft. from W. Line

Location _____

Rig up _____

Drilling and Remarks:

Tap L. 1855

2049-1904

RECORD

Cased _____ in., _____ ft.

Sand _____

Gas _____

Oil _____

Total Depth _____

PRODUCTION

1st 24 hrs. Nat. _____

1st 24 hrs. after shot _____

Gas _____ Cu. Ft.

Dry Hole _____

Abandoned _____

Date

AUG 6 1924

192

M. A. BENEAR

Scout