

Map No. Kansas Sec. 27 Twp. 22 R. 13
 Well No. 1 Miller Farm
R. G. Gillespie Company

NORTH

SOUTH

WEST

EAST

3

Location _____

Drilling Remarks

RECORD

Cased _____ in. _____ ft.

Sand _____

Gas _____

Oil _____

Total Depth _____

Rig Up _____

Drilling Remarks

PRODUCTION

1st 24 hrs. Nat. _____

1st. 24 hrs. after shot _____

Gas _____ cu. ft.

Dry Hole _____


Abandoned _____

Map No. Kansas Sec. 27 Twp. 22 R. 13Well No. 1 muller FarmR. G. Gillespie Company1020 Ft. from N. Line

Ft. from S. Line

100 Ft. from E. Line

Ft. from W. Line

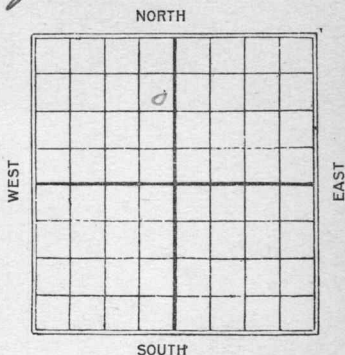

C.

Date

REPORT

7/25

Rig up

5/29

Sh 400

6/5

✓ 1000

6/17

✓ 1700

6/19

F 1870-73-6" csg. collapsed
fsg. 350' oil in hole

6/26

F 1870-73' pumped 35 bbls 1st
24 hrs, 10 bbls Int. deeper.

7/3

Sd. 1870-73 T.O. 11 bbls pump
some water

Map No. 5420 Sec. 27 Twp. 22 R. 13Well No. 1 Miller
R. L. Gillespie Company

Contractor

FIRST REPORTS

SECTION PLAT

1020 Ft. from N. Line

Ft. from S. Line

100 Ft. from E. Line

Ft. from W. Line

	0		

Location Rig up

Drilling and Remarks:

RECORD

Cased in., ft.Sand Gas Oil Total Depth

PRODUCTION

1st 24 hrs. Nat. 1st 24 hrs. after shot Gas Cu. Ft.Dry Hole Abandoned

Date

MAY 21 1925

192

CHAS. L. SHERWOOD

Scout

Map No. 114nd Sec. 27 Twp. 22 R. 13Well No. 1 Miller
R. D. Dillspie Company

Contractor

COMPLETED

1020 Ft. from N. Line

Ft. from S. Line

100 Ft. from E. Line

Ft. from W. Line

SECTION PLAT

Location

Rig up

Drilling and Remarks:

Ramping 11 bbls
natural
showing some
water.

RECORD

Cased _____ in., _____ ft.

Sand 1870-1873

Gas _____

Oil _____

Total Depth 1873'

PRODUCTION

1st 24 hrs. Nat. _____

1st 24 hrs. after shot _____

Gas _____ Cu. Ft.

Dry Hole _____

Abandoned _____

Date

JUL 3 1925

CHAS. L. SHERWOOD

102

Scout