


Map No. _____ Sec. 27 Twp. 22 R. 13E
 Well No. 7 Koenig Farm _____
R. J. Gillespie Company _____

NORTH

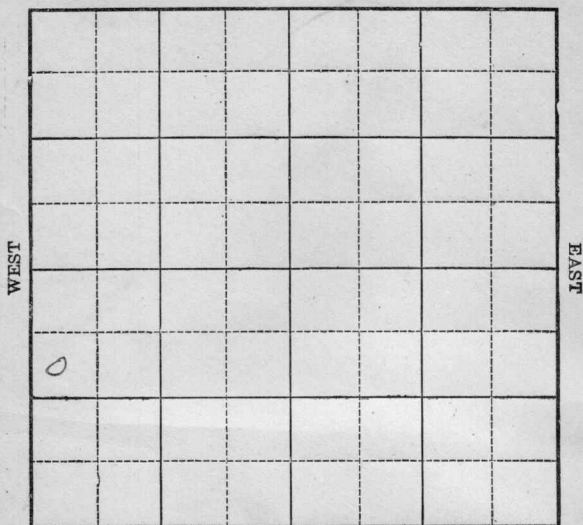

SOUTH

Location _____

Drilling Remarks:

Rig up _____

Drilling Remarks:

RECORD

Cased _____ in. _____ ft.

Sand _____

Gas _____

Oil _____

Total Depth _____

PRODUCTION

1st 24 hrs Nat. _____

1st 24 hrs. after shot _____

Gas _____ cu. ft.

Dry Hole _____

Abandoned _____

Map No. _____ Sec. 27 Twp. 22 R. 13

Well No. 7 Koenig Farm


R. J. Gillespie Company

990 Ft. from N, Line

Ft. from S. Line

Ft. from E. Line

330 Ft. from W. Line

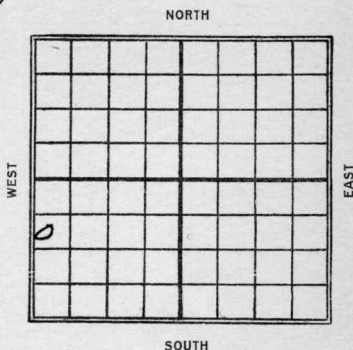

Date _____

REPORT

Date
1923

6/23	Ring
------	------

 $\frac{8}{4}$

8/15	Top line 1876 - D x A. 1965'
------	---------------------------------

Map No. KANSAS Sec. 27 Twp. 22 R. 13Well No. 7 - KaenicR. G. Gillette Company

Contractor

FIRST REPORT

SECTION PLAT

990 Ft. from N. Line

Ft. from S. Line

Ft. from E. Line

330 Ft. from W. Line

0			

Location

Rig up ✓✓

Drilling and Remarks:

RECORD

Cased _____ in., _____ ft.

Sand _____

Gas _____

Oil _____

Total Depth _____

PRODUCTION

1st 24 hrs. Nat. _____

1st 24 hrs. after shot _____

Gas _____ Cu. Ft.

Dry Hole _____

Abandoned _____

Date

JUN 23 1923

M. A. BENEAR

192_____

Scout

No Map
 Map No. _____ Sec. *27* Twp. *22* R. *13*

Well No. *7* _____

R. B. Gillette Company

Contractor _____

ABANDONED SECTION PLAT

990 _____ Ft. from N. Line

_____ Ft. from S. Line

_____ Ft. from E. Line

330 _____ Ft. from W. Line

Location _____

Rig up _____

Drilling and Remarks:

Top Line 1876
L O & A
1965

RECORD

Cased _____ in., _____ ft.

Sand _____

Gas _____

Oil _____

Total Depth _____

PRODUCTION

1st 24 hrs. Nat. _____

1st 24 hrs. after shot _____

Gas _____ Cu. Ft.

Dry Hole _____

Abandoned _____

Date

AUG 15 1923

192

M. A. BENEAR

Scout