
FORM 51 25M 3-49 PETROL Greenwood KANSAS

Section 12 Township 23 Range 9E

Well No. #1 Green - Hawthorne

Company Miller & Snyder

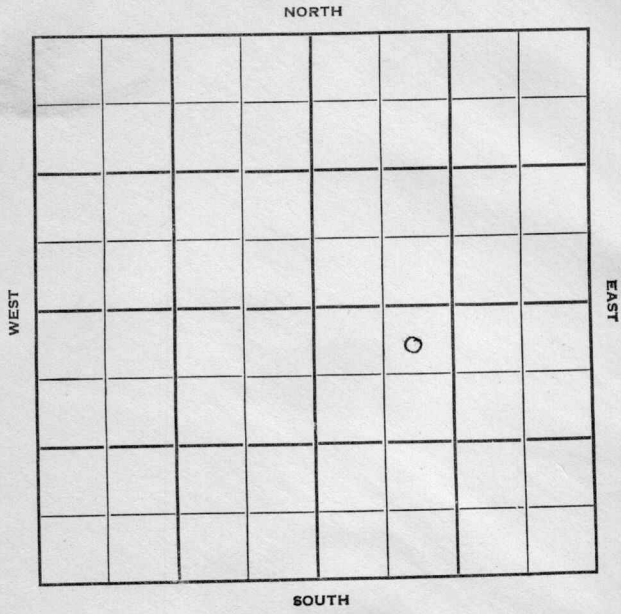

FORM 252-B
10M 8-51 TPCO.

Greenwood KANSAS

Sec. 12 Twp. 23 R. 9 E

Well No. # 1 Green-Hawthorne Farm

Miller & Snyder Company

Contractor

Wildcat


330 Ft. from N. Line

Ft. from S. Line

Ft. from E. Line

990 Ft. from W. Line

NE NW SE

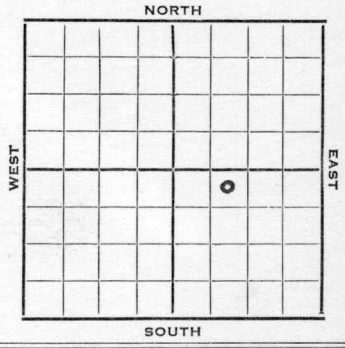

1952	Elev. - REPORT
6/4	Spud 5-9-52 8" @ 50' Bart 2295' TD 2300' 5" @ 2291'
6/11	Spud 5-9052 Oil Well TD 2328' 8" @ 50' Bart. 2295 TD 2300' 5" @ 2291' DD 2328 Comp. 10 bopd

COMPLETED

FORM 275 FOR SALE BY KANSAS BLUE PRINT CO.

County Greenwood State Kansas

Sec. 12 (Blk. Twp.) 23 (Sur. Rge.) 9E Map No.

Operator Miller & Snyder

Well No. 1 Farm Green - Hawthorne

Elev. Location NE NW SE



330 Ft. From N Line SE

990 Ft. From W Line Quarter

1st. Report JUN 4 1952

Completion

Remarks

Spudding Date 5-9-52

Drlg. Data Wildcat

8" @ 50 Bart. 2295 TD 2300 5" @ 2291

J. G. McGEHEE

FORM 275 FOR SALE BY KANSAS BLUE PRINT CO


County Greenwood State Kansas

Sec. 12 (Blk. / Twp.) 23 (Sur. / Rge.) 9E Map No.

Operator Miller & Snyder

Well No. 1 Farm Green - Hawthorne

Elev. Location NE NW SE

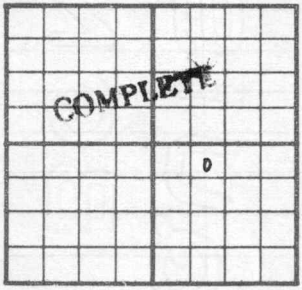

330 Ft. From N Line SE

990 Ft. From W Line Quarter

1st. Report

Completion JUN 11 1952

Remarks Wildcat

Spudding Date 5-9-52

Drlg. Data Oil well TD 2328

8"@ 50 Bart. 2295 TD 2300 5" @ 2291

DD 2328 Comp. 10 bopd

J. G. McGEHEE